

ADMINISTRATION BUILDING FOUNDATION PLAN

Scaled 1/16" = 1'-0"


1:2

DESIGNED BY	PROJECT NO.
CHECKED BY	SHEET NO.
DATE	15 OF
DRAWN BY	S2.1
ISSUE DATE	SHEETS
PROJECT REF.	
CLIENT REF.	

STAR VALLEY RANCH ASSOCIATION
 AS-BUILT DRAWINGS
 STAR VALLEY RANCH
 ADMIN. BLDG. FOUNDATION PLAN

SARGENT
 Sargent Engineers, Inc.
 1290 Arrowhead Plaza Way
 Driggs, Idaho 83422
 Tel. 208 354-4400 • Fax 208 354-4420

Rev.	Date	By	Description

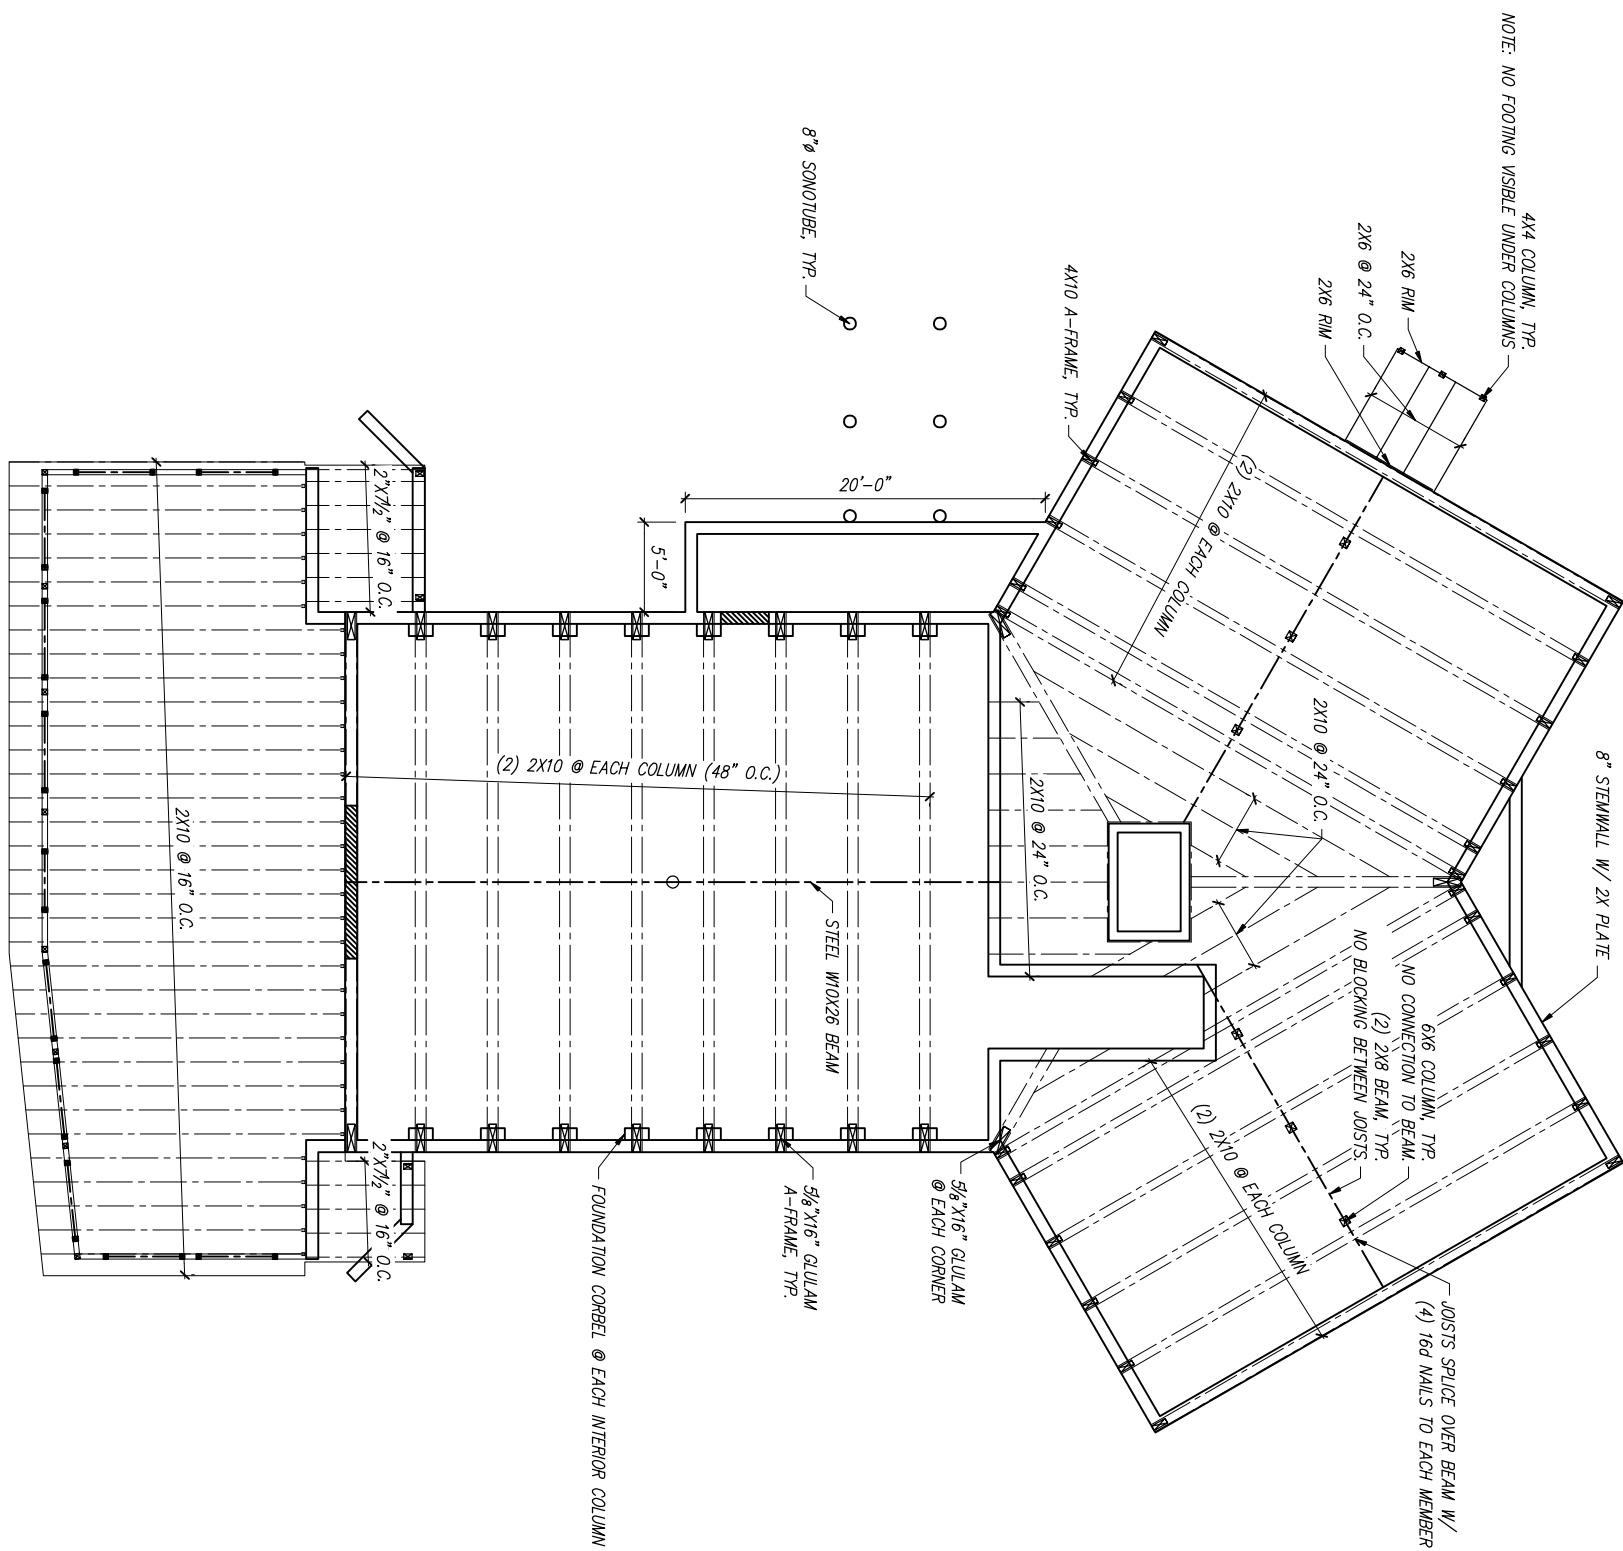

ADMINISTRATION BUILDING 1ST FLOOR FRAMING PLAN

Scaled 1/16" = 1'-0"

1:2


SHEET NO.	S2.2	OF	15
SHEETS			

STAR VALLEY RANCH ASSOCIATION
AS-BUILT DRAWINGS
STAR VALLEY RANCH
ADMIN. BLDG. 1ST FLOOR FRAMING

Designed by:	
Checked by:	
Proj. Director:	MHH
Drafter:	MHH
Issue Date:	10/15/2009
Project Ref.:	009135.00
Client Ref.:	

SARGENT
Sargent Engineers, Inc.
1290 Arrowhead Plaza Way
Driggs, Idaho 83422
Tel. 208 354-4400 • Fax 208 354-4420

Rev.	Date	By	Description

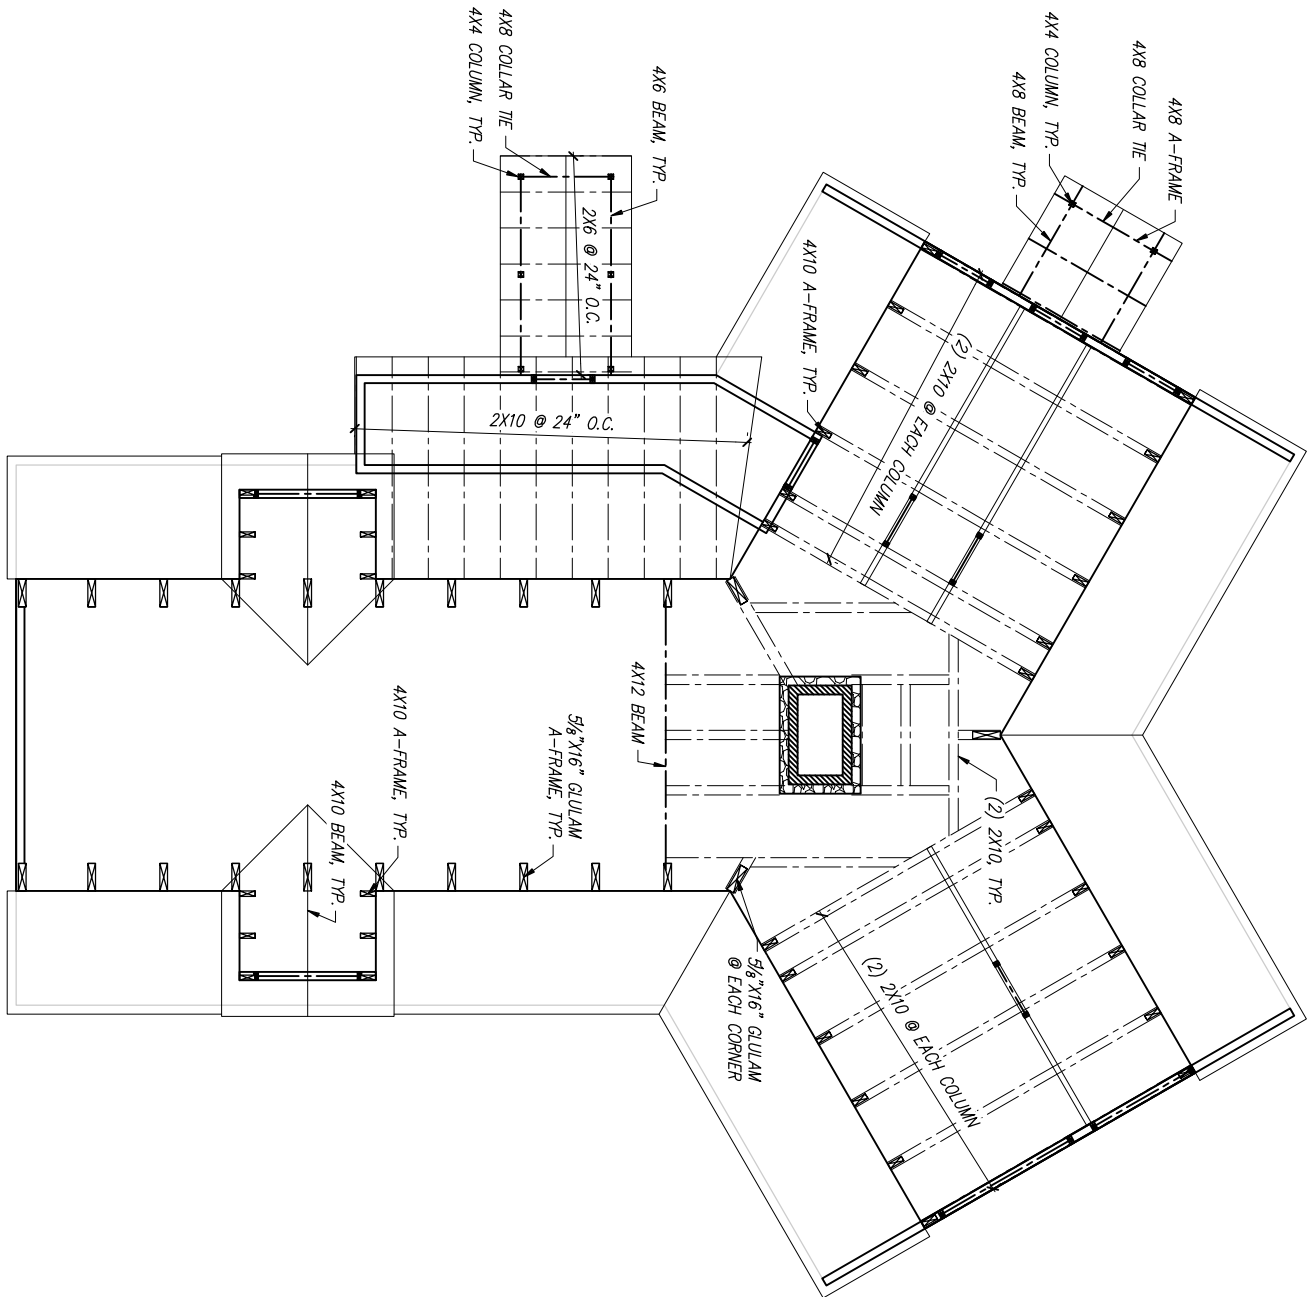

ADMINISTRATION BUILDING 2ND FLOOR FRAMING PLAN

Scaled 1/6" = 1'-0"

1:2


SHEET NO.	15	OF	15
SHEETS			

STAR VALLEY RANCH ASSOCIATION
AS-BUILT DRAWINGS
STAR VALLEY RANCH
ADMIN. BLDG. 2ND FLOOR FRAMING

Designed by:	
Checked by:	
Proj. Director:	MHH
Drafter:	MHH
Issue Date:	10/15/2009
Project Ref.:	009135.00
Client Ref.:	

SARGENT
Sargent Engineers, Inc.
1290 Arrowhead Plaza Way
Driggs, Idaho 83422
Tel. 208 354-4400 • Fax 208 354-4420

Rev.	Date	By	Description

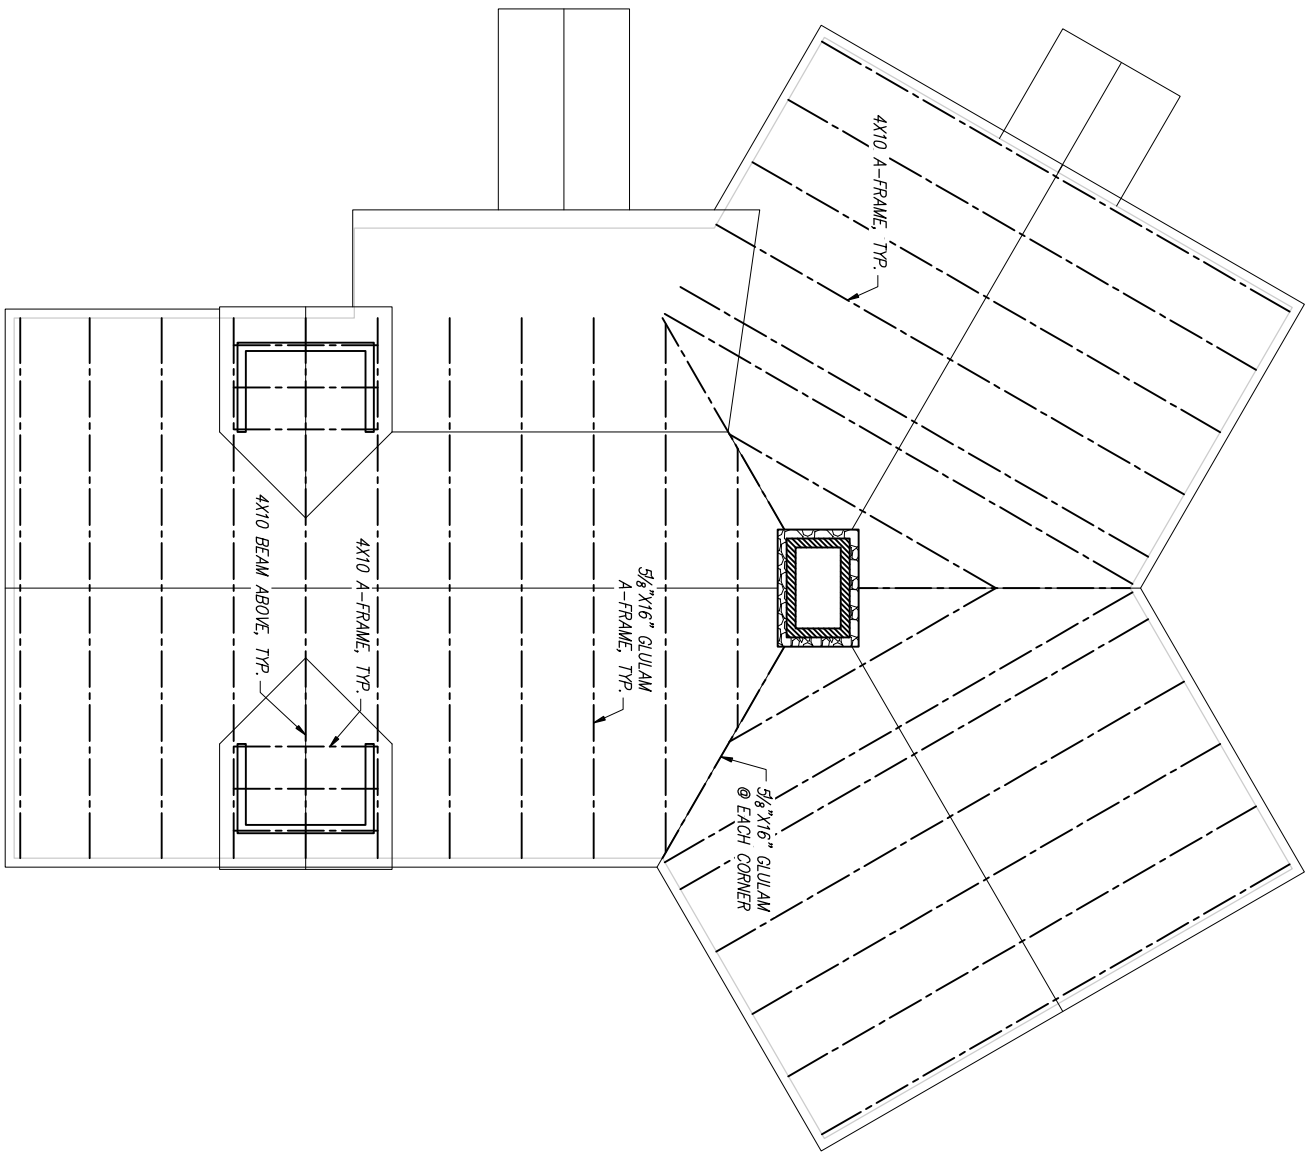

ADMINISTRATION BUILDING ROOF FRAMING PLAN

Scaled 1/6" = 1'-0"



1:2

DESIGNED BY	PROJECT NO.	DATE
CHECKED BY	S2.4	10/15/2009
PROJECT NO.	15	09135.00
DATE	OF	
10/15/2009	15	
09135.00		

STAR VALLEY RANCH ASSOCIATION
 AS-BUILT DRAWINGS
 STAR VALLEY RANCH
 ADMIN. BLDG. ROOF FRAMING PLAN

SARGENT
 Sargent Engineers, Inc.
 1290 Arrowhead Plaza Way
 Driggs, Idaho 83422
 Tel. 208 354-4400 • Fax 208 354-4420

Rev.	Date	By	Description

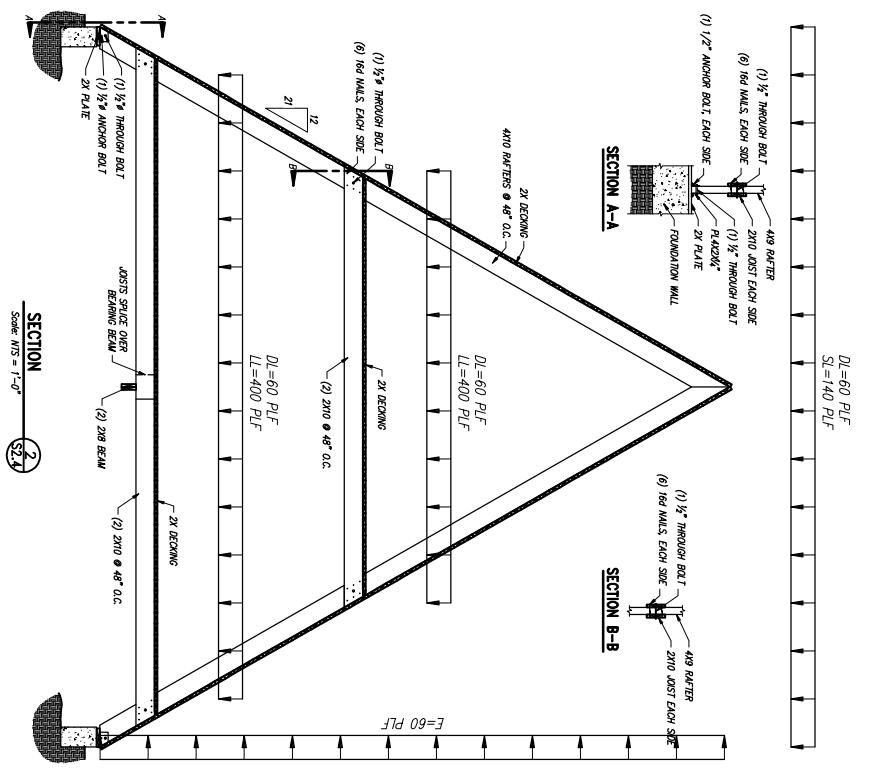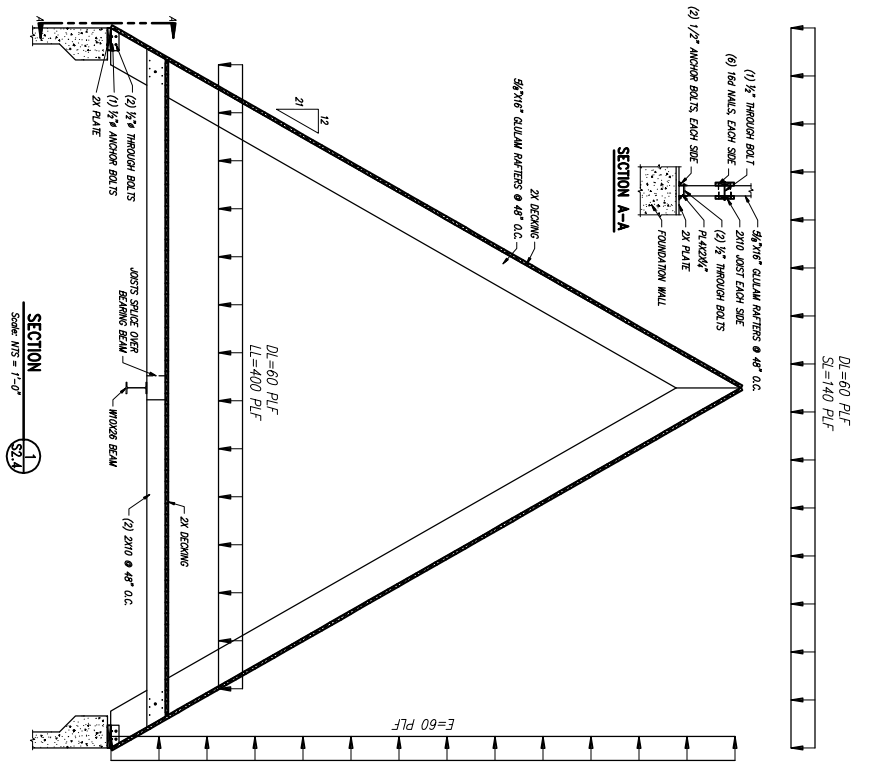


DESIGNED BY	CHKD BY
PROJECT REF.	DATE
SHEET NO. 15 OF 15	

STAR VALLEY RANCH ASSOCIATION
 AS-BUILT DRAWINGS
 STAR VALLEY RANCH
 ADMIN. BLDG. SECTIONS

SARGENT
 Sargent Engineers, Inc.
 1290 Arrowhead Plaza Way
 Driggs, Idaho 83422
 Tel. 208 354-4400 • Fax 208 354-4420

Rev.	Date	By	Description

1:2

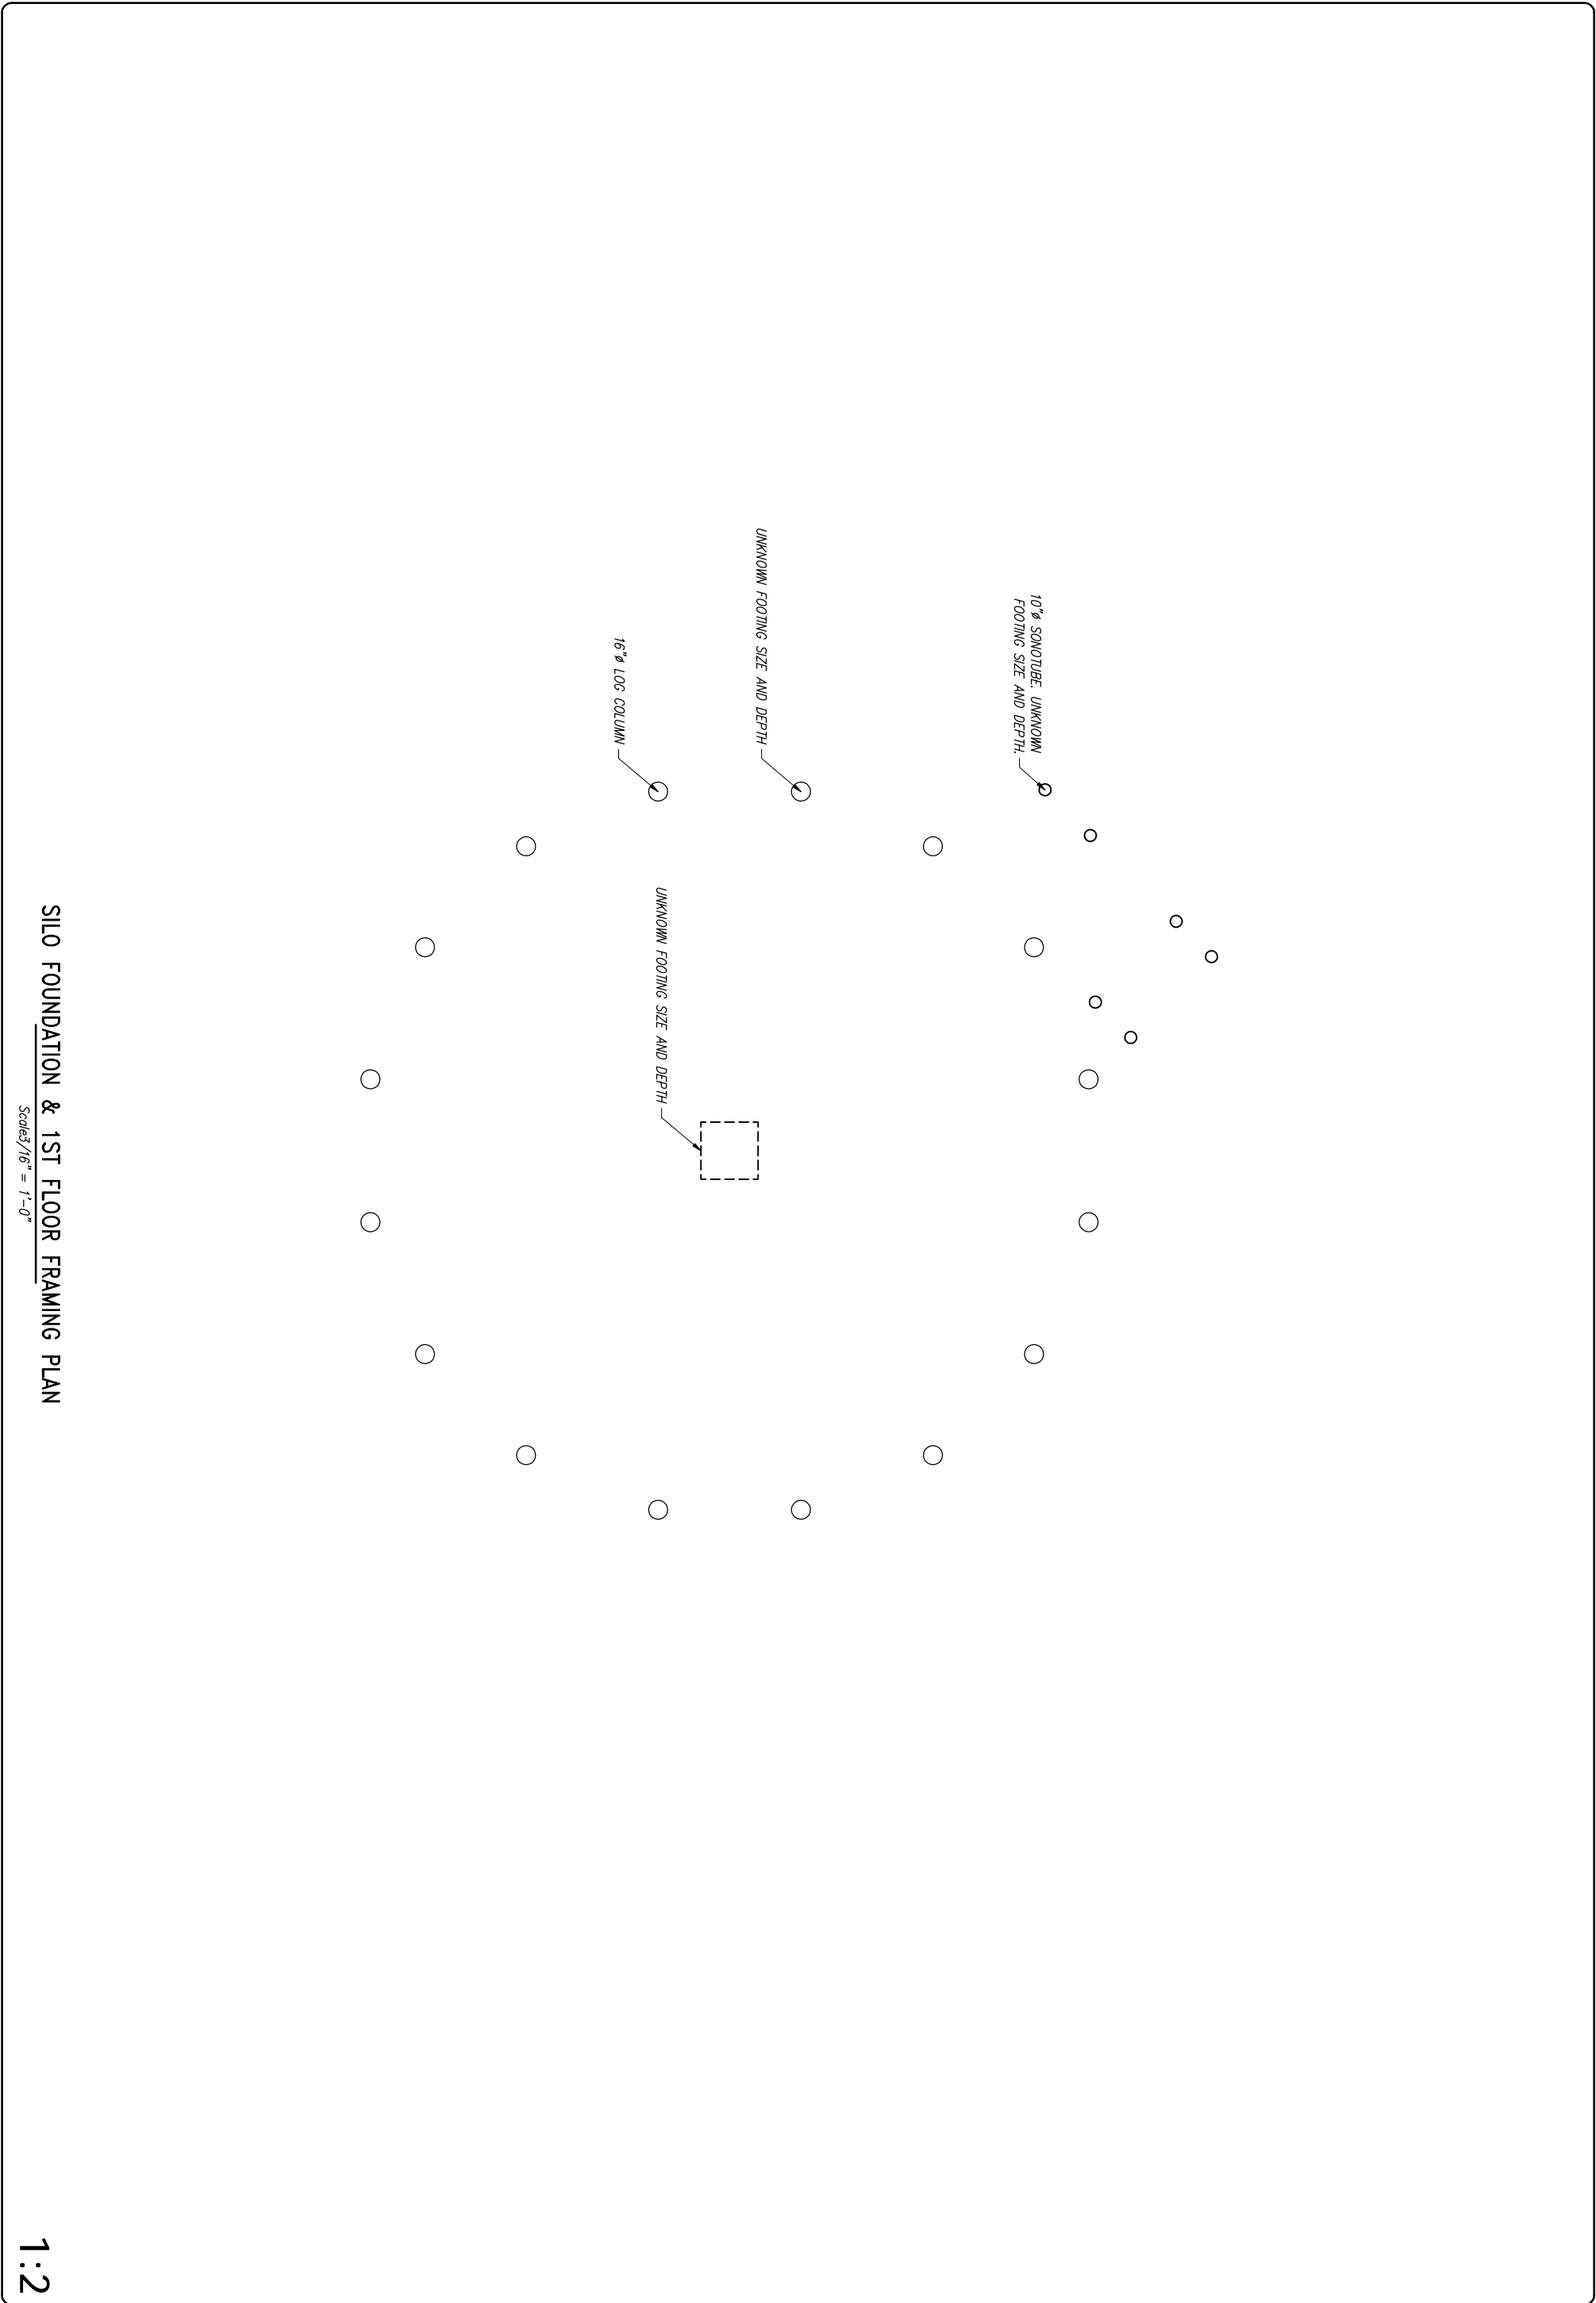

SILO FOUNDATION & 1ST FLOOR FRAMING PLAN

Scaled 1/16" = 1'-0"

1:2


DESIGNED BY	Checked by
Proj. Director	MHH
Draftsman	MHH
Issue Date	10/15/2009
Project Ref.	009135.00
Client Ref.	

STAR VALLEY RANCH ASSOCIATION
 AS-BUILT DRAWINGS
 STAR VALLEY RANCH
 SILO FOUND. & 1ST FL. PLAN

SARGENT
 Sargent Engineers, Inc.
 1290 Arrowhead Plaza Way
 Driggs, Idaho 83422
 Tel. 208 354-4400 • Fax 208 354-4420

Rev.	Date	By	Description

SHEET NO. 15 OF 15 SHEETS

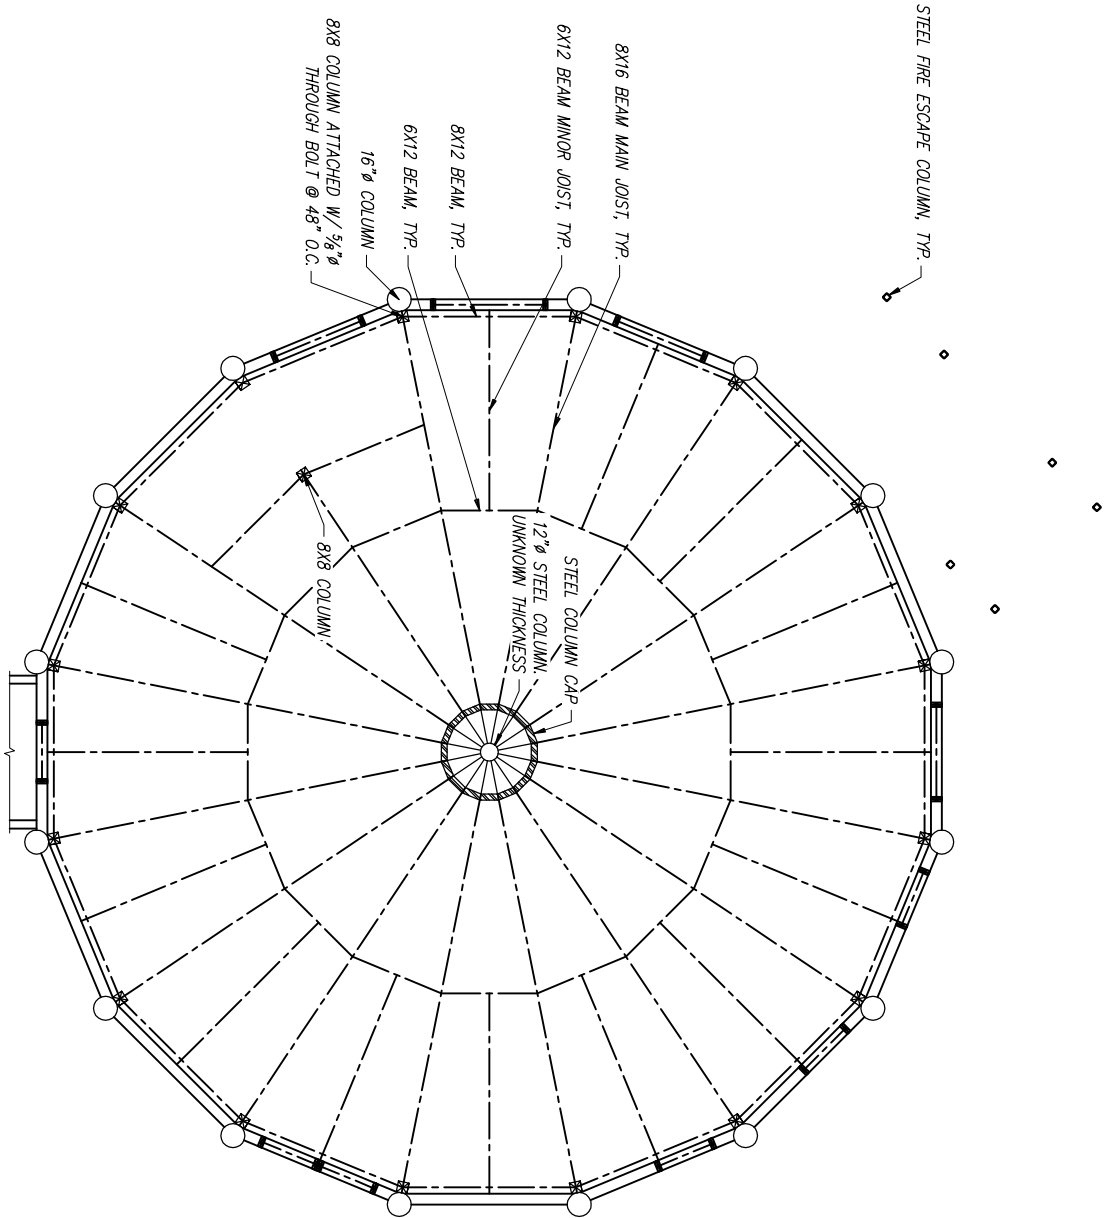

SILO 2ND FLOOR FRAMING PLAN

Scaled 1/6" = 1'-0"


1:2

DESIGNED BY	PROJECT	DATE
CHECKED BY	DRAWN BY	ISSUE DATE
PROJECT NO.	DRAWING NO.	CLIENT REF.
S3.2	15	
SHEETS		

STAR VALLEY RANCH ASSOCIATION
 AS-BUILT DRAWINGS
 STAR VALLEY RANCH
 SILO 2ND FLOOR FRAMING PLAN

SARGENT
 Sargent Engineers, Inc.
 1290 Arrowhead Plaza Way
 Driggs, Idaho 83422
 Tel. 208 354-4400 • Fax 208 354-4420

Rev.	Date	By	Description

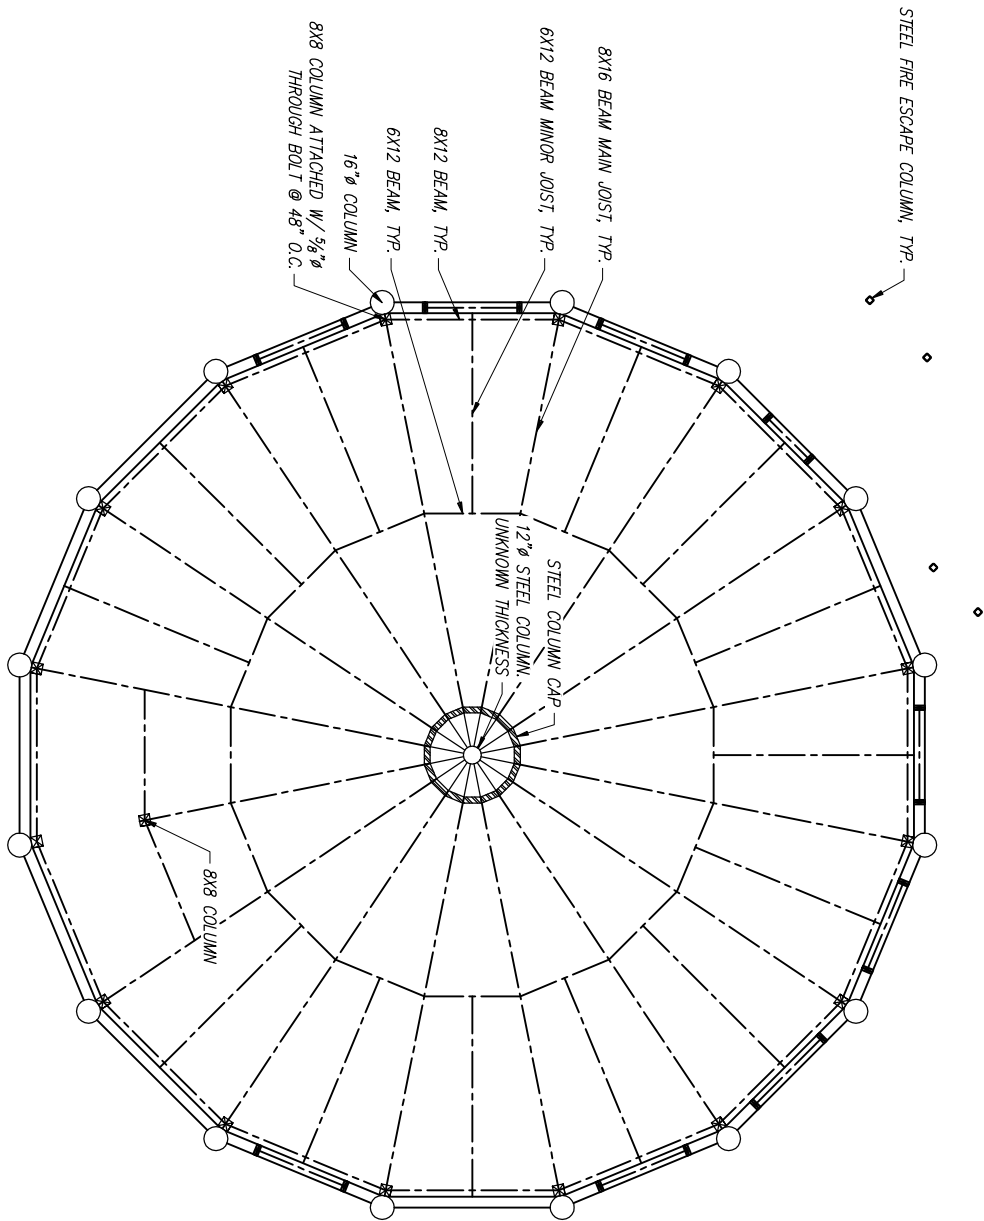

SILO 3RD FLOOR FRAMING PLAN

Scaled 1/16" = 1'-0"


1:2

SHEET NO.	OF
S3.3	15
SHEETS	

STAR VALLEY RANCH ASSOCIATION AS-BUILT DRAWINGS STAR VALLEY RANCH SILO 3RD FLOOR FRAMING PLAN
--

SARGENT
 Sargent Engineers, Inc.
 1290 Arrowhead Plaza Way
 Driggs, Idaho 83422
 Tel. 208 354-4400 • Fax 208 354-4420

Rev.	Date	By	Description

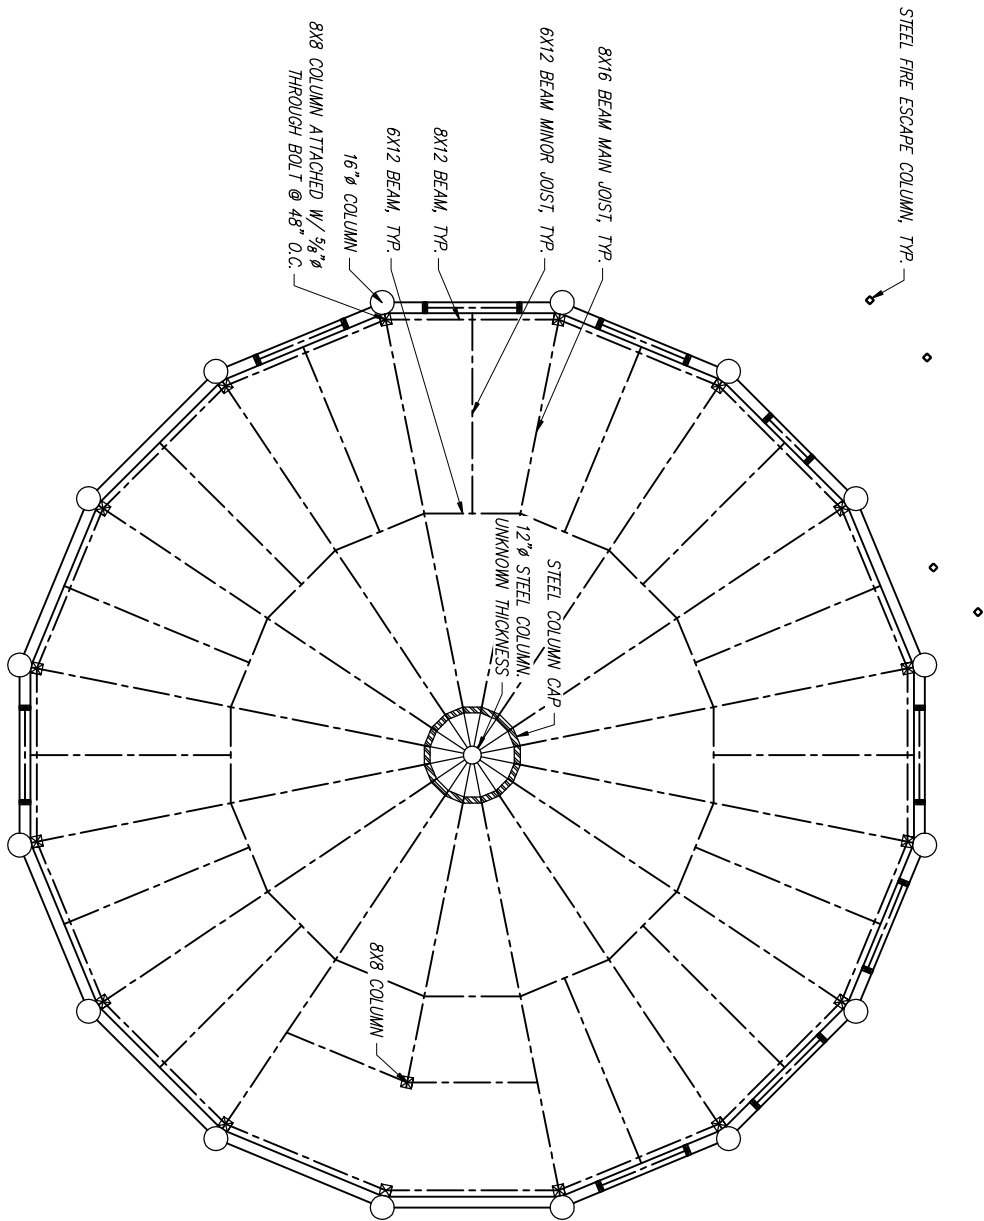

SILO 4TH FLOOR FRAMING PLAN

Scaled 1/6" = 1'-0"


1:2

SHEET NO.	OF
S3.4	15
SHEETS	

STAR VALLEY RANCH ASSOCIATION AS-BUILT DRAWINGS STAR VALLEY RANCH SILO 4TH FLOOR FRAMING PLAN
--

SARGENT
 Sargent Engineers, Inc.
 1290 Arrowhead Plaza Way
 Driggs, Idaho 83422
 Tel. 208 354-4400 • Fax 208 354-4420

Rev.	Date	By	Description

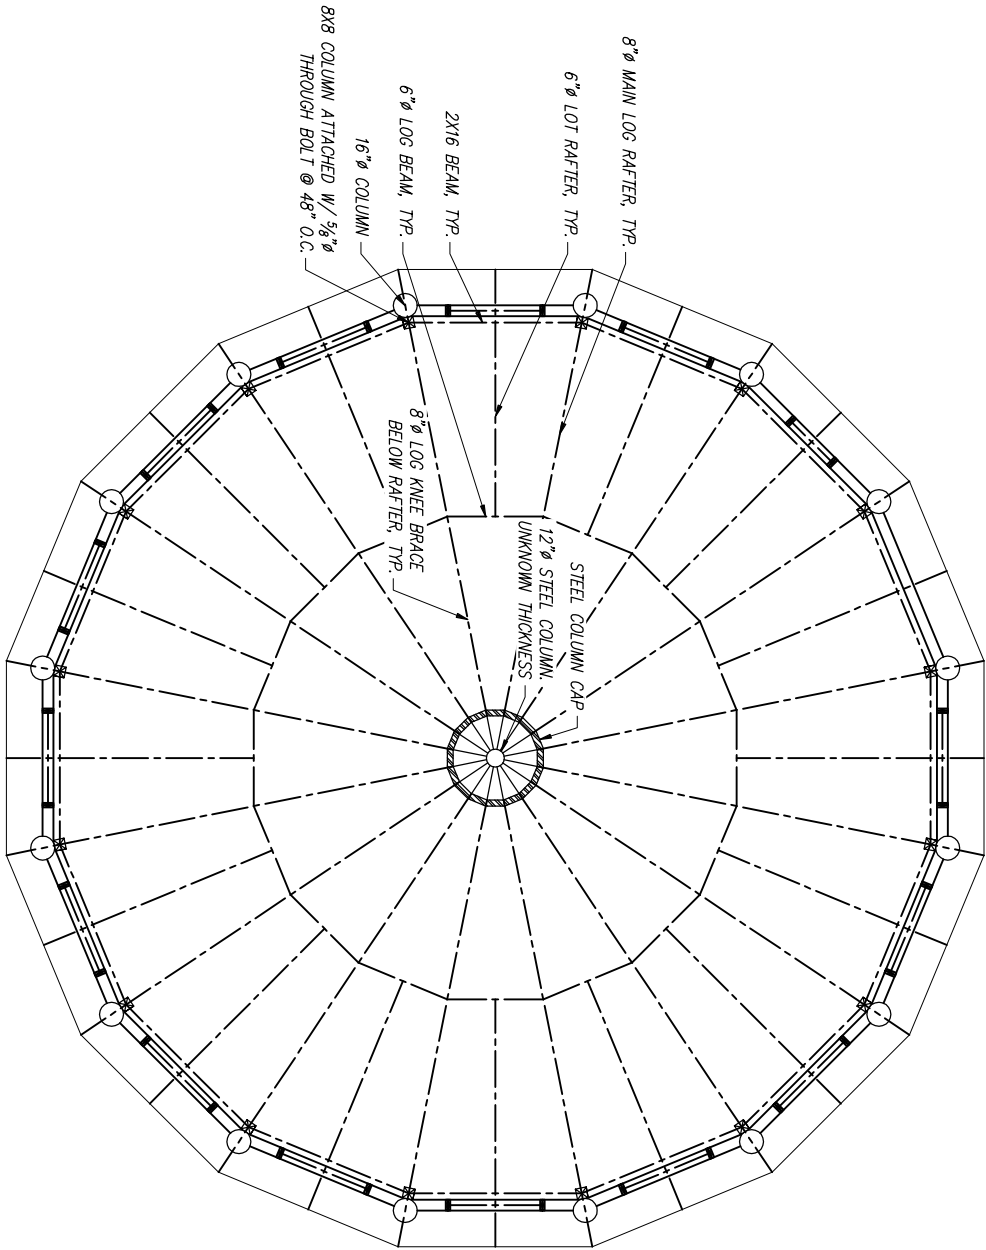

SILO ROOF FRAMING PLAN
 Scaled 1/6" = 1'-0"


1:2

SHEET NO.	33.5	OF	15
SHEETS			

STAR VALLEY RANCH ASSOCIATION AS-BUILT DRAWINGS STAR VALLEY RANCH SILO ROOF FRAMING PLAN

SARGENT
 Sargent Engineers, Inc.
 1290 Arrowhead Plaza Way
 Driggs, Idaho 83422
 Tel. 208 354-4400 • Fax 208 354-4420

Rev.	Date	By	Description

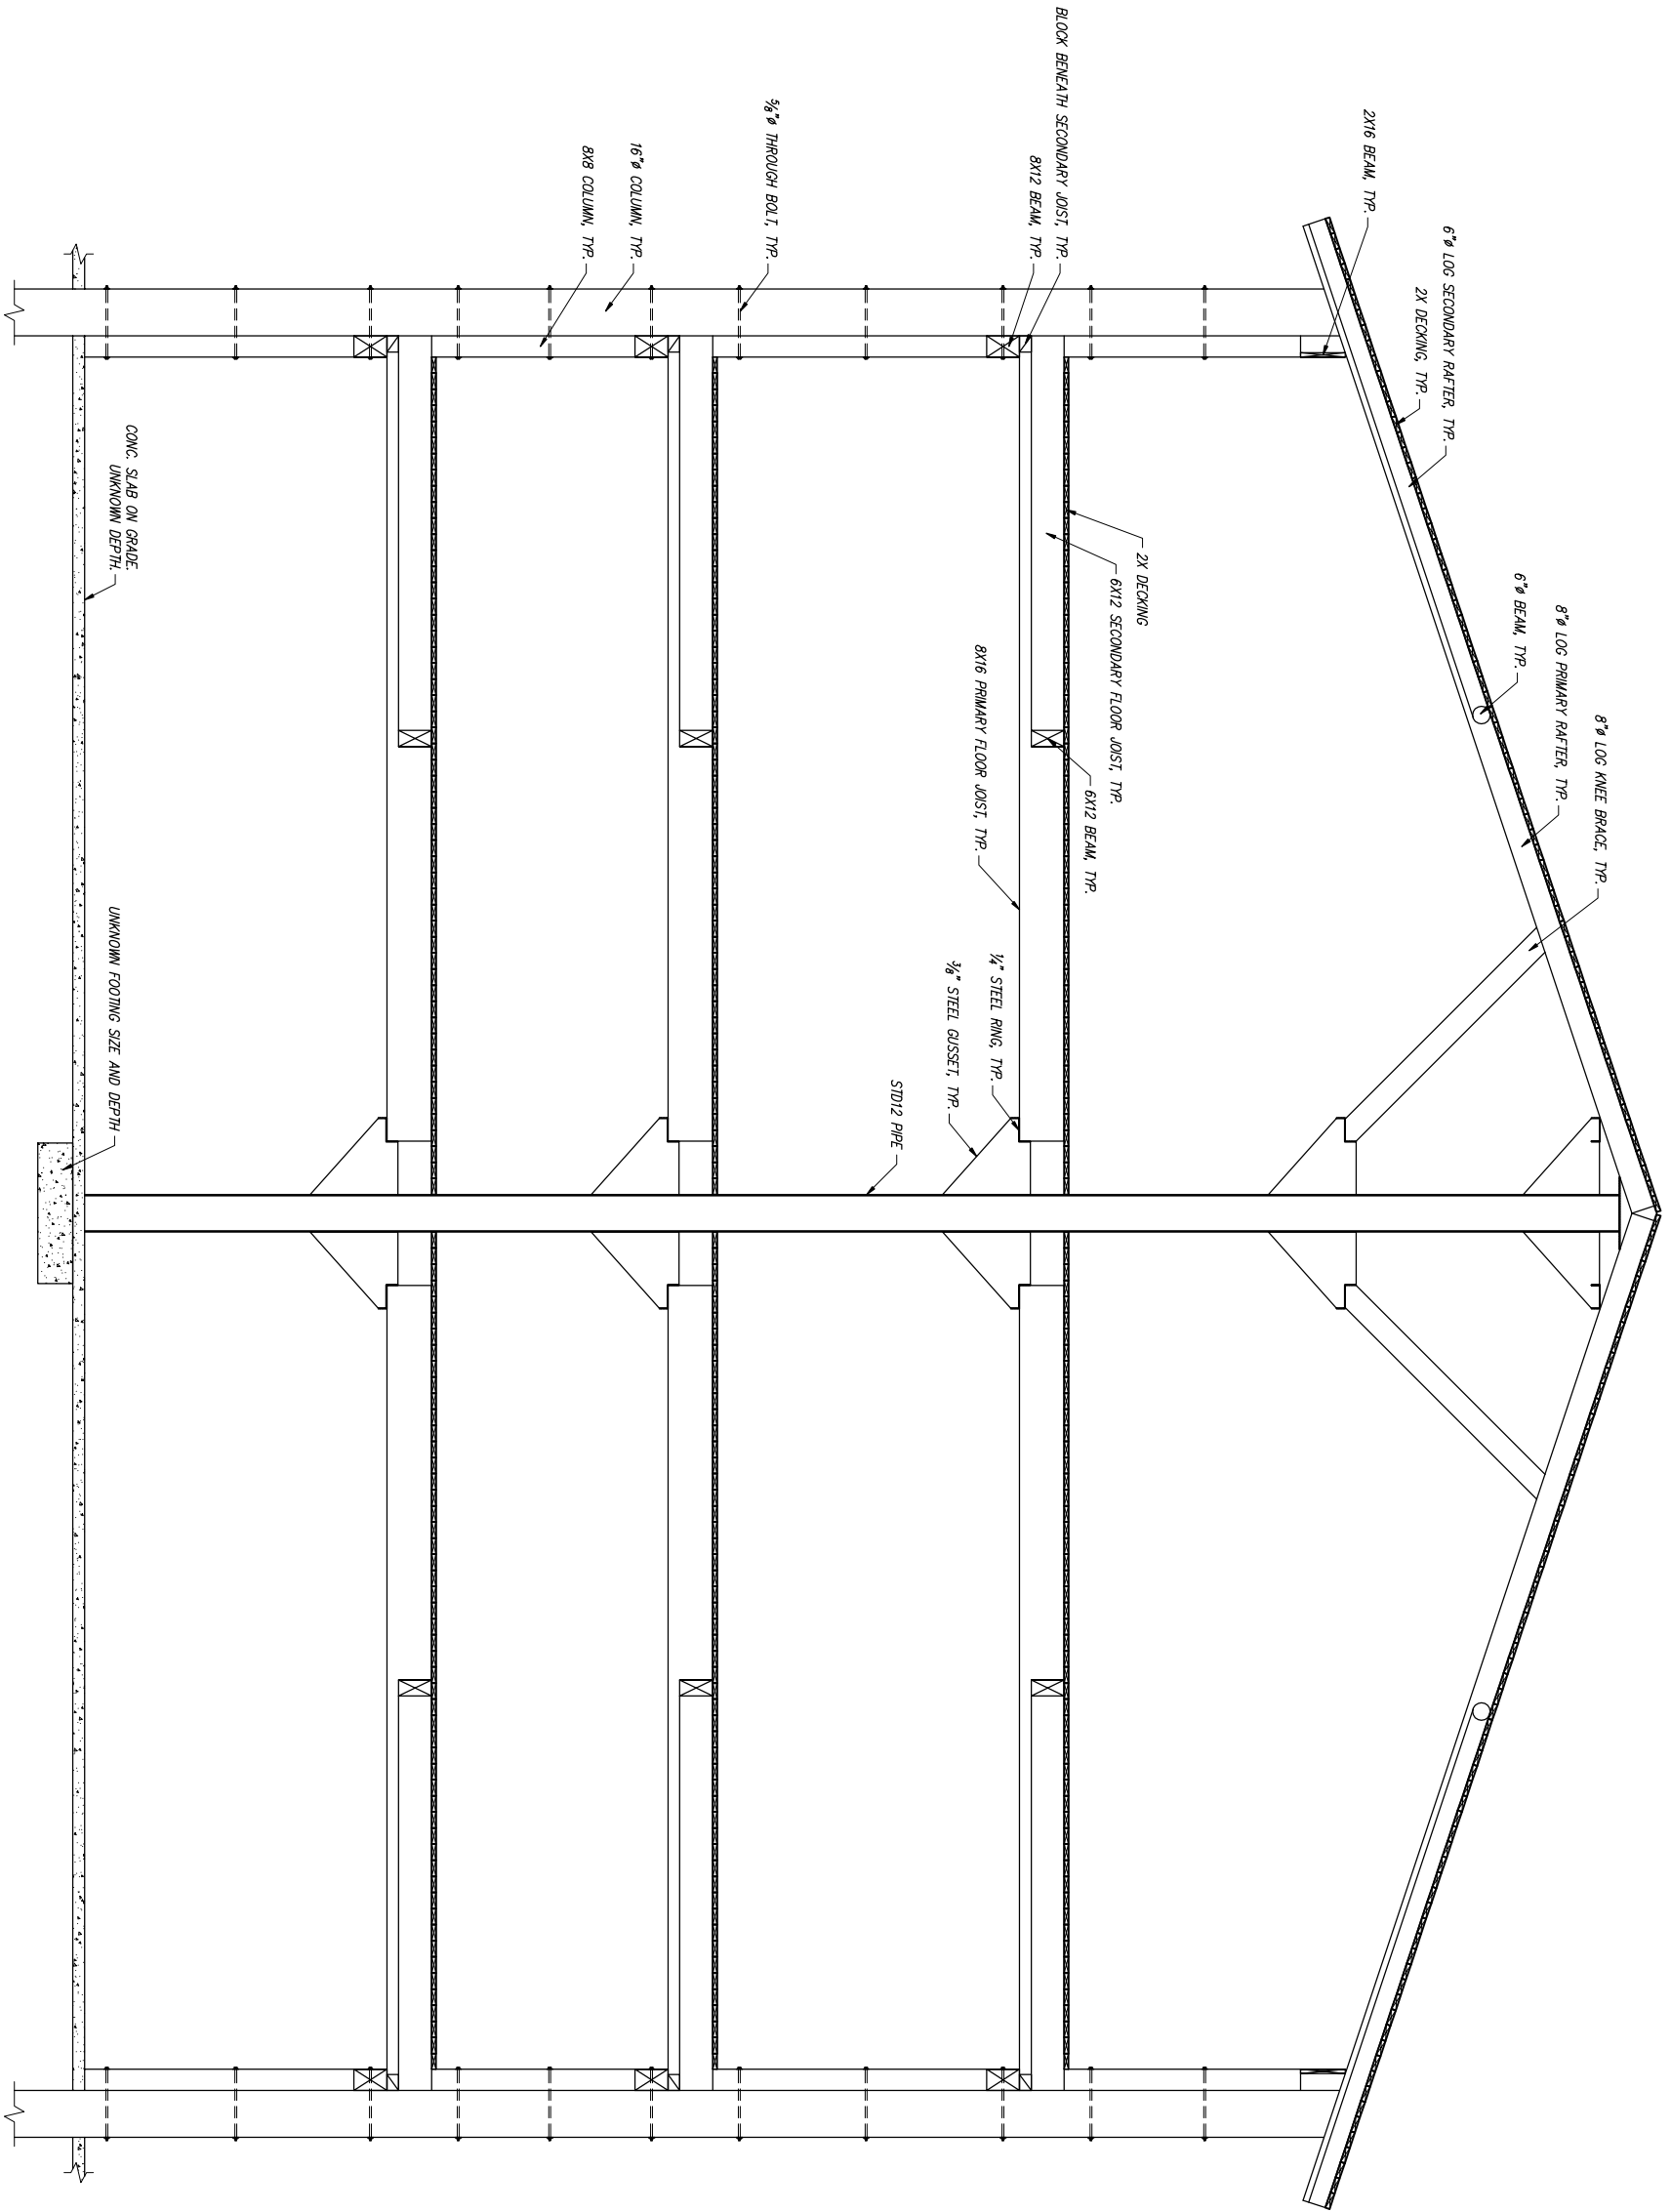

SILO SECTION
Scaled 1/16" = 1'-0"


1:2

SHEET NO.	OF
S3.5	15
SHEETS	

STAR VALLEY RANCH ASSOCIATION AS-BUILT DRAWINGS STAR VALLEY RANCH SILO SECTION

SARGENT
 Sargent Engineers, Inc.
 1290 Arrowhead Plaza Way
 Driggs, Idaho 83422
 Tel. 208 354-4400 • Fax 208 354-4420

Rev.	Date	By	Description

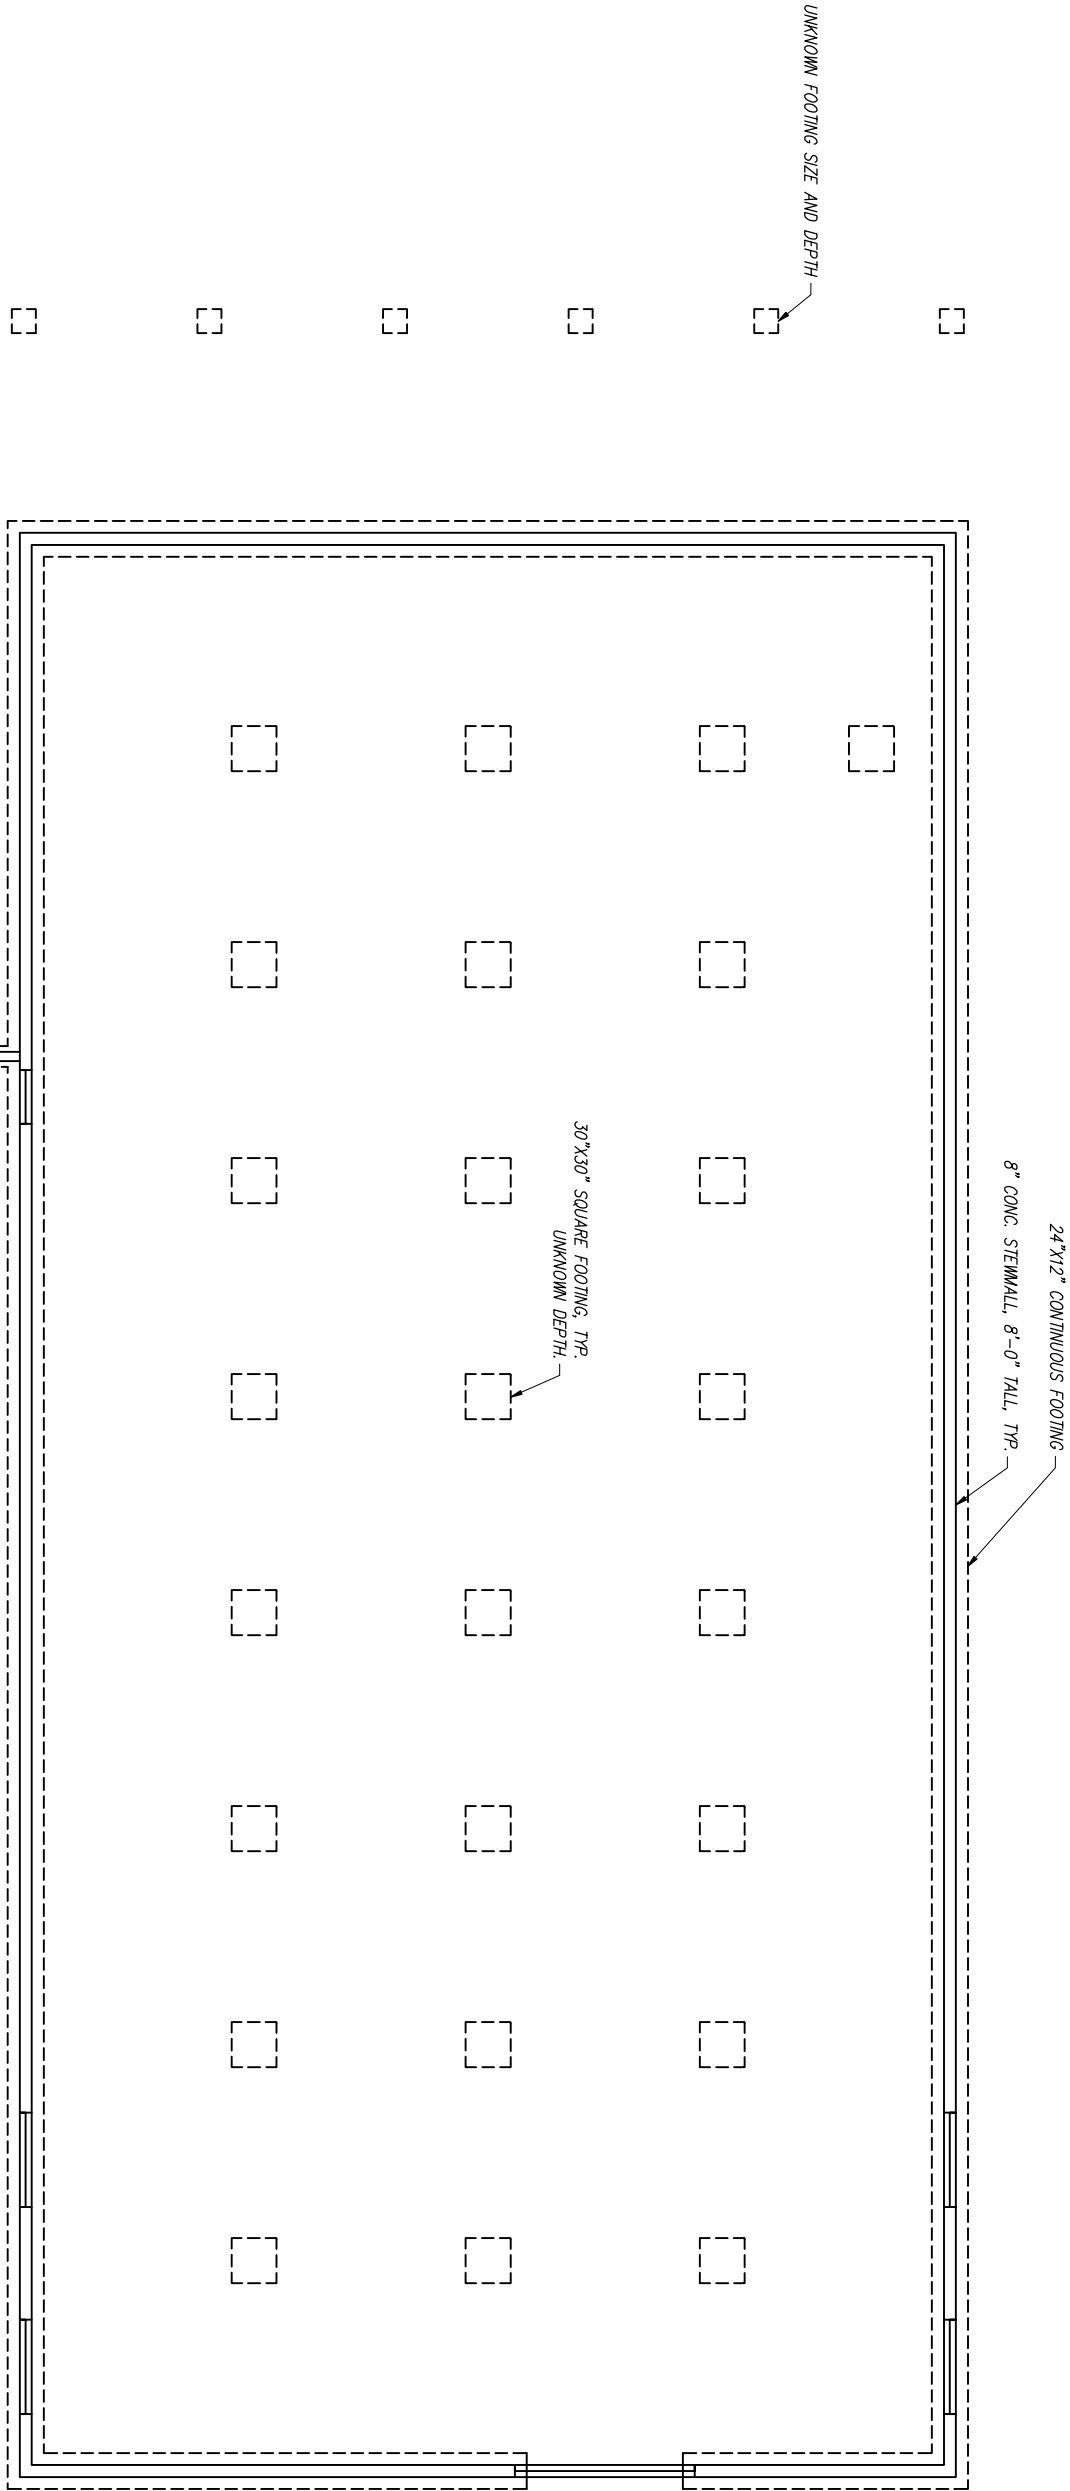

BARN FOUNDATION PLAN

Scaled 1/6" = 1'-0"

1:2


DESIGNED BY	Checked by
Proj. Designer	MHH
Drafter	MHH
Issue Date	10/15/2009
Project Ref.	009135.00
Client Ref.	

STAR VALLEY RANCH ASSOCIATION
 AS-BUILT DRAWINGS
 STAR VALLEY RANCH
 BARN FOUNDATION PLAN

SARGENT
 Sargent Engineers, Inc.
 1290 Arrowhead Plaza Way
 Driggs, Idaho 83422
 Tel. 208 354-4400 • Fax 208 354-4420

Rev.	Date	By	Description

SHEET NO. S4.1 OF 15 SHEETS

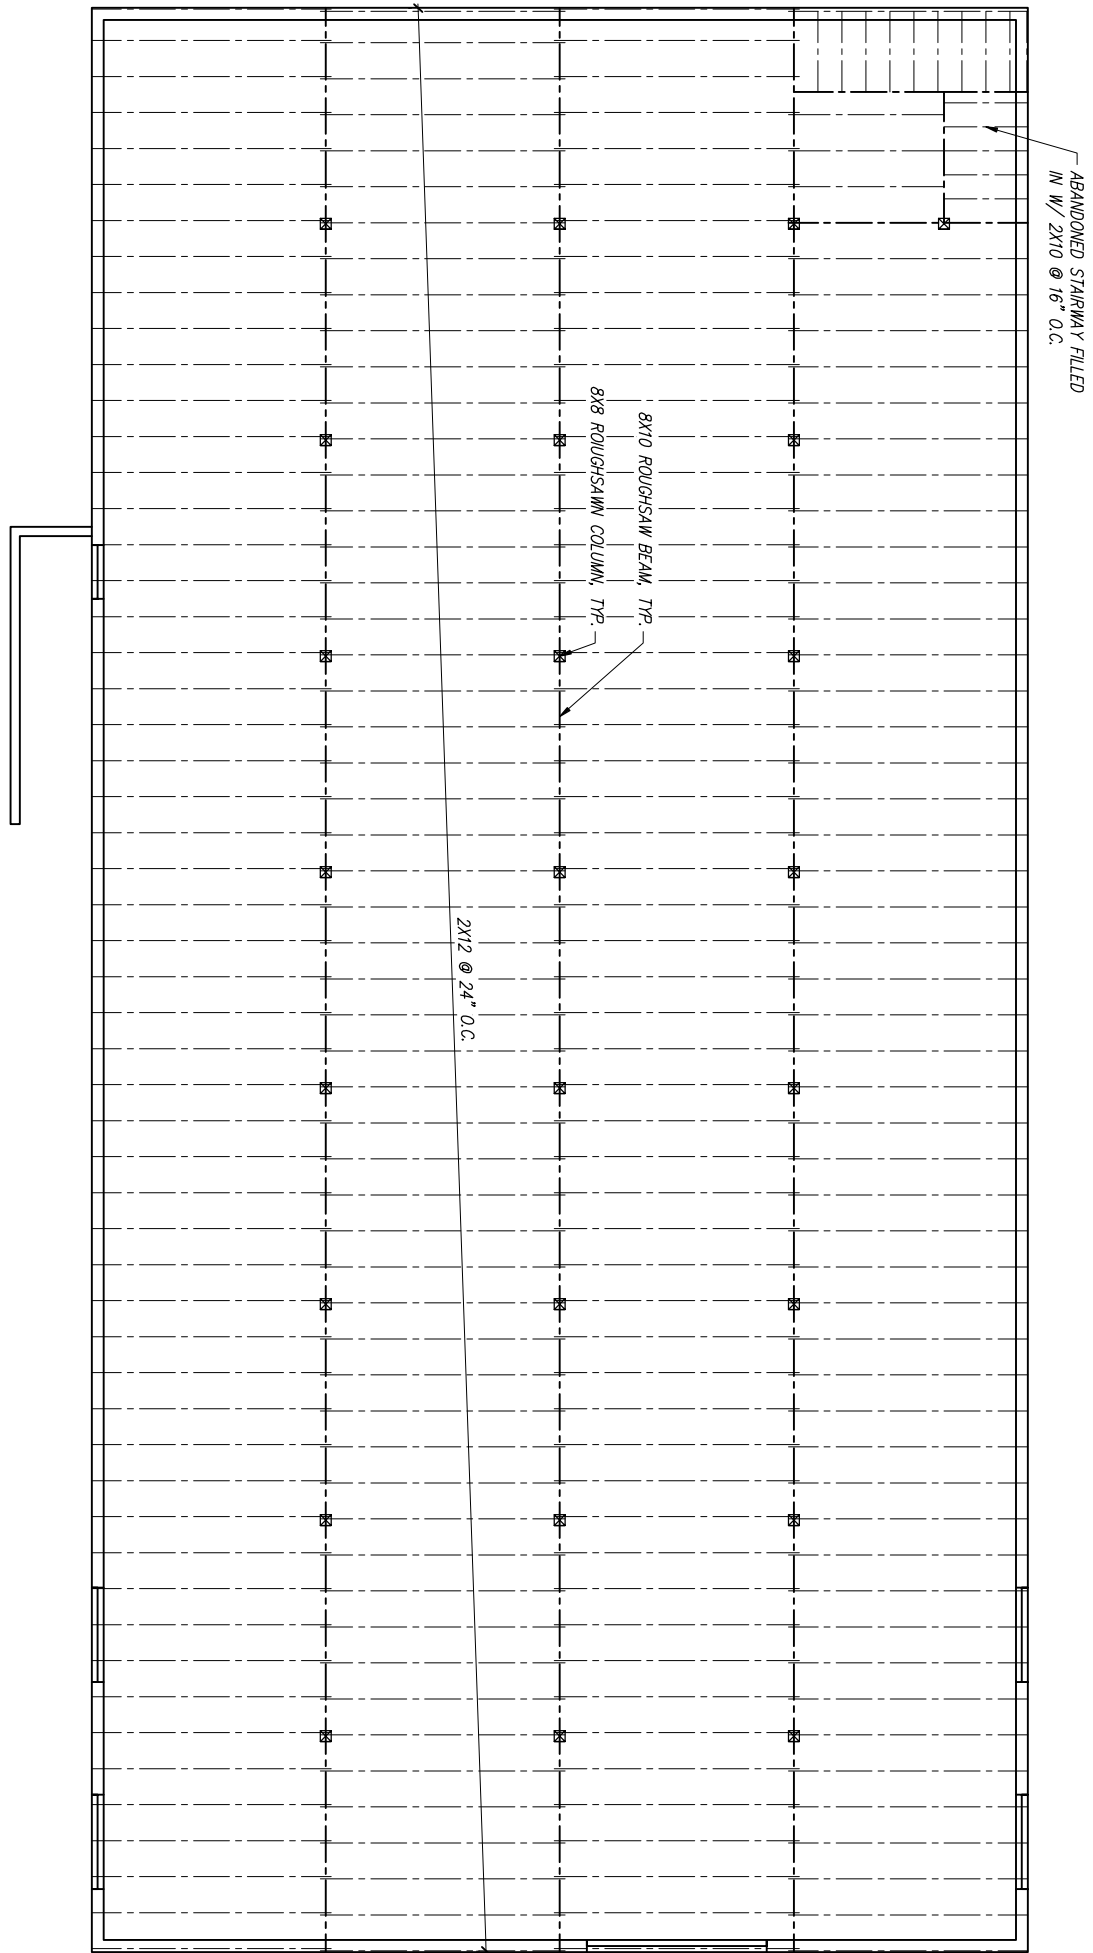

BARN 1ST FLOOR FRAMING PLAN

Scaled 1/16" = 1'-0"


1:2

SHEET NO.	S4.2	OF	15
SHEETS			

STAR VALLEY RANCH ASSOCIATION AS-BUILT DRAWINGS STAR VALLEY RANCH BARN 1ST FLOOR FRAMING PLAN
--

SARGENT
 Sargent Engineers, Inc.
 1290 Arrowhead Plaza Way
 Driggs, Idaho 83422
 Tel. 208 354-4400 • Fax 208 354-4420

Rev.	Date	By	Description

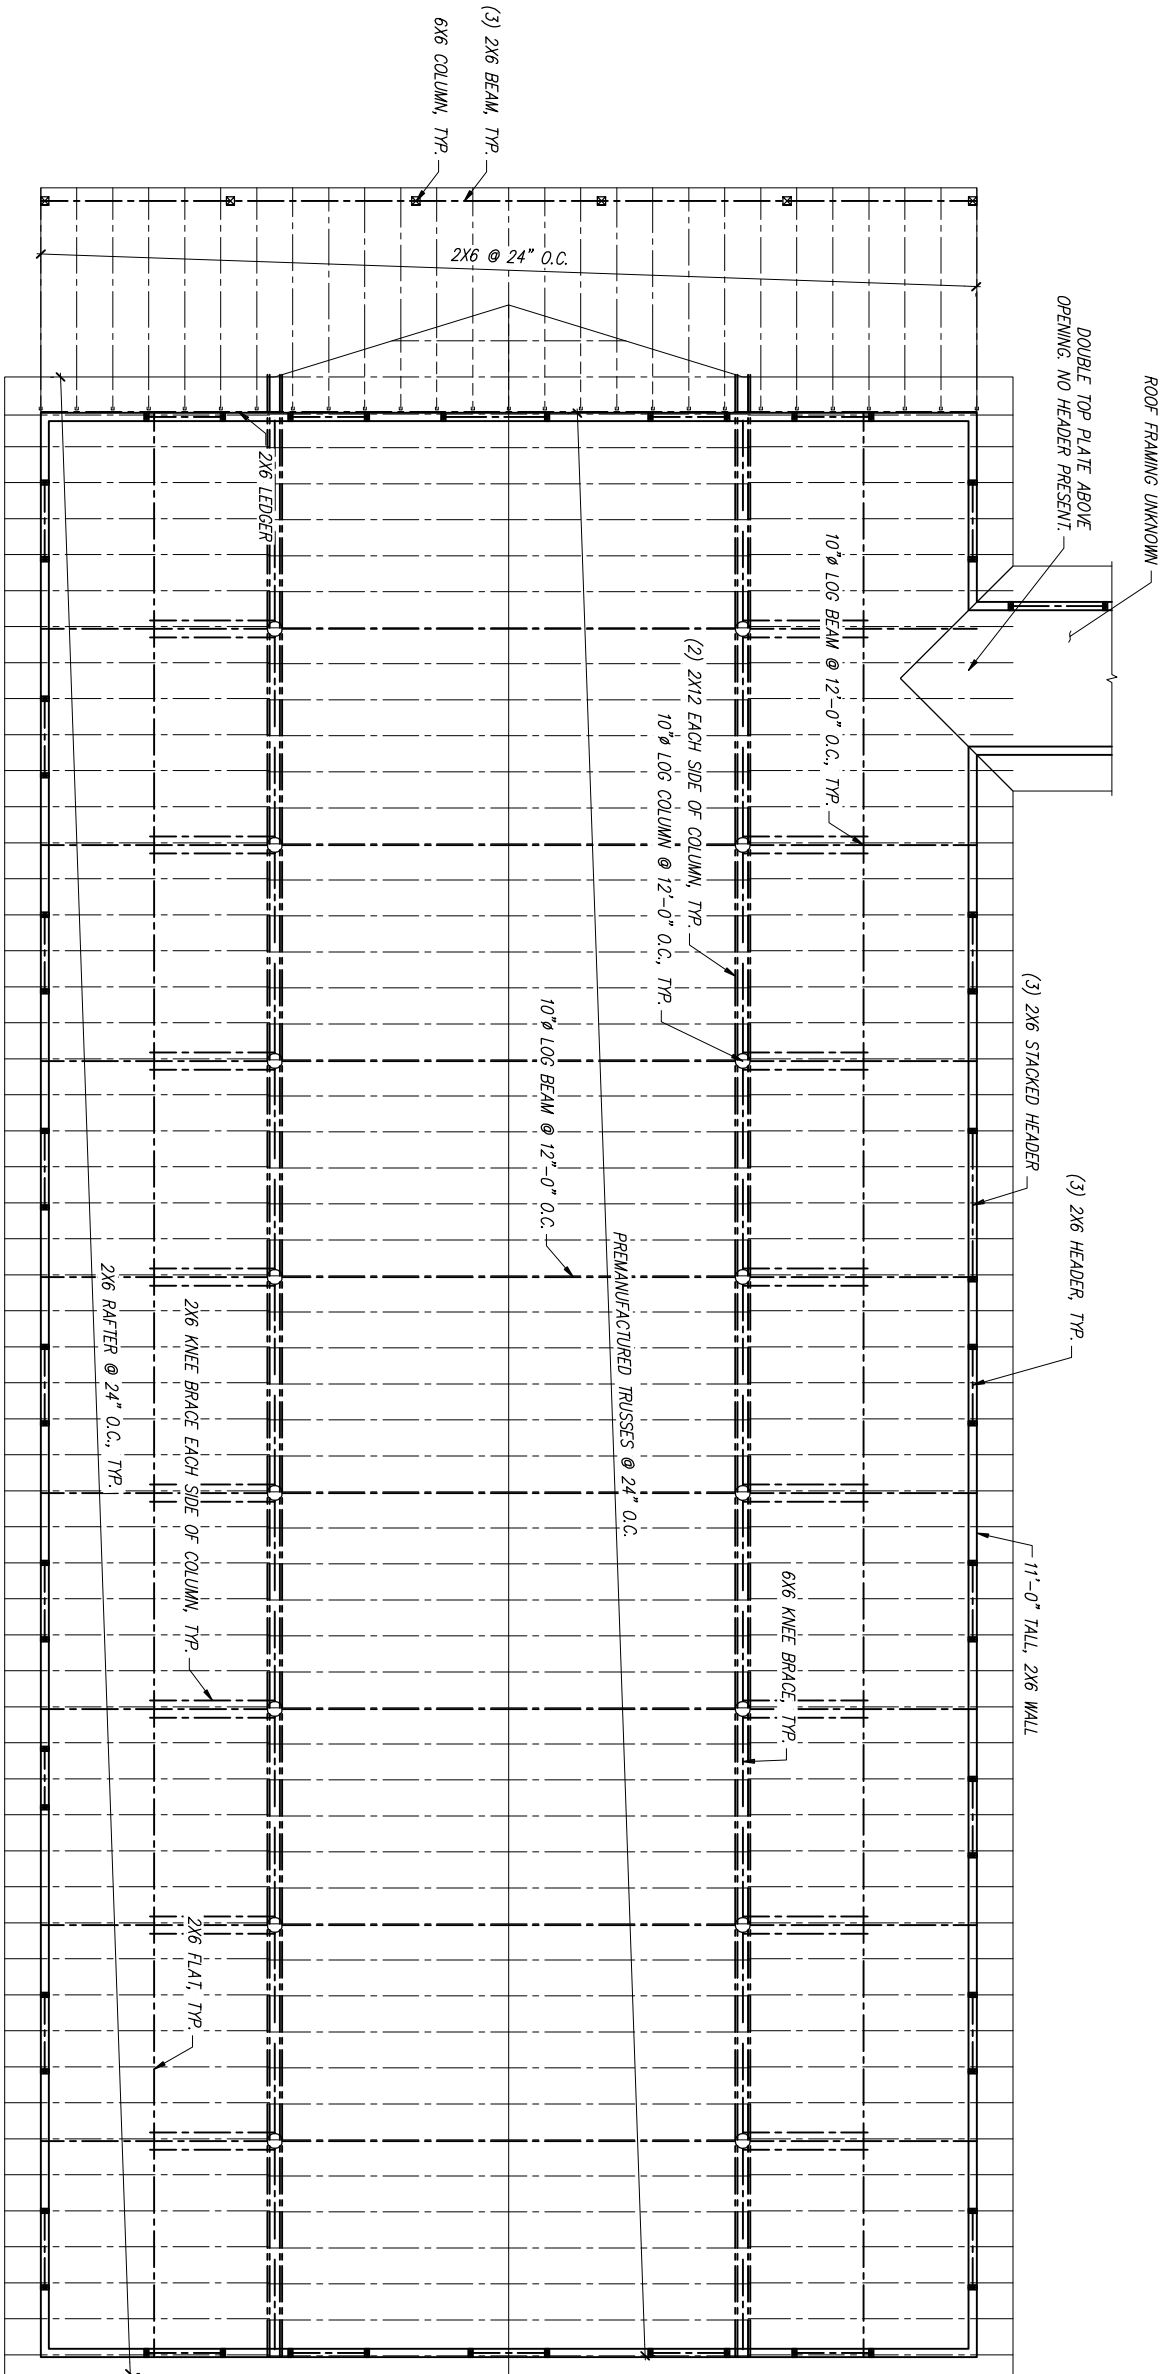

BARN ROOF FRAMING PLAN

Scaled 1/16" = 1'-0"


1:2

SHEET NO.	S4.3	OF	15
SHEETS			

STAR VALLEY RANCH ASSOCIATION
 AS-BUILT DRAWINGS
 STAR VALLEY RANCH
 BARN ROOF FRAMING PLAN

SARGENT
 Sargent Engineers, Inc.
 1290 Arrowhead Plaza Way
 Driggs, Idaho 83422
 Tel. 208 354-4400 • Fax 208 354-4420

Rev.	Date	By	Description

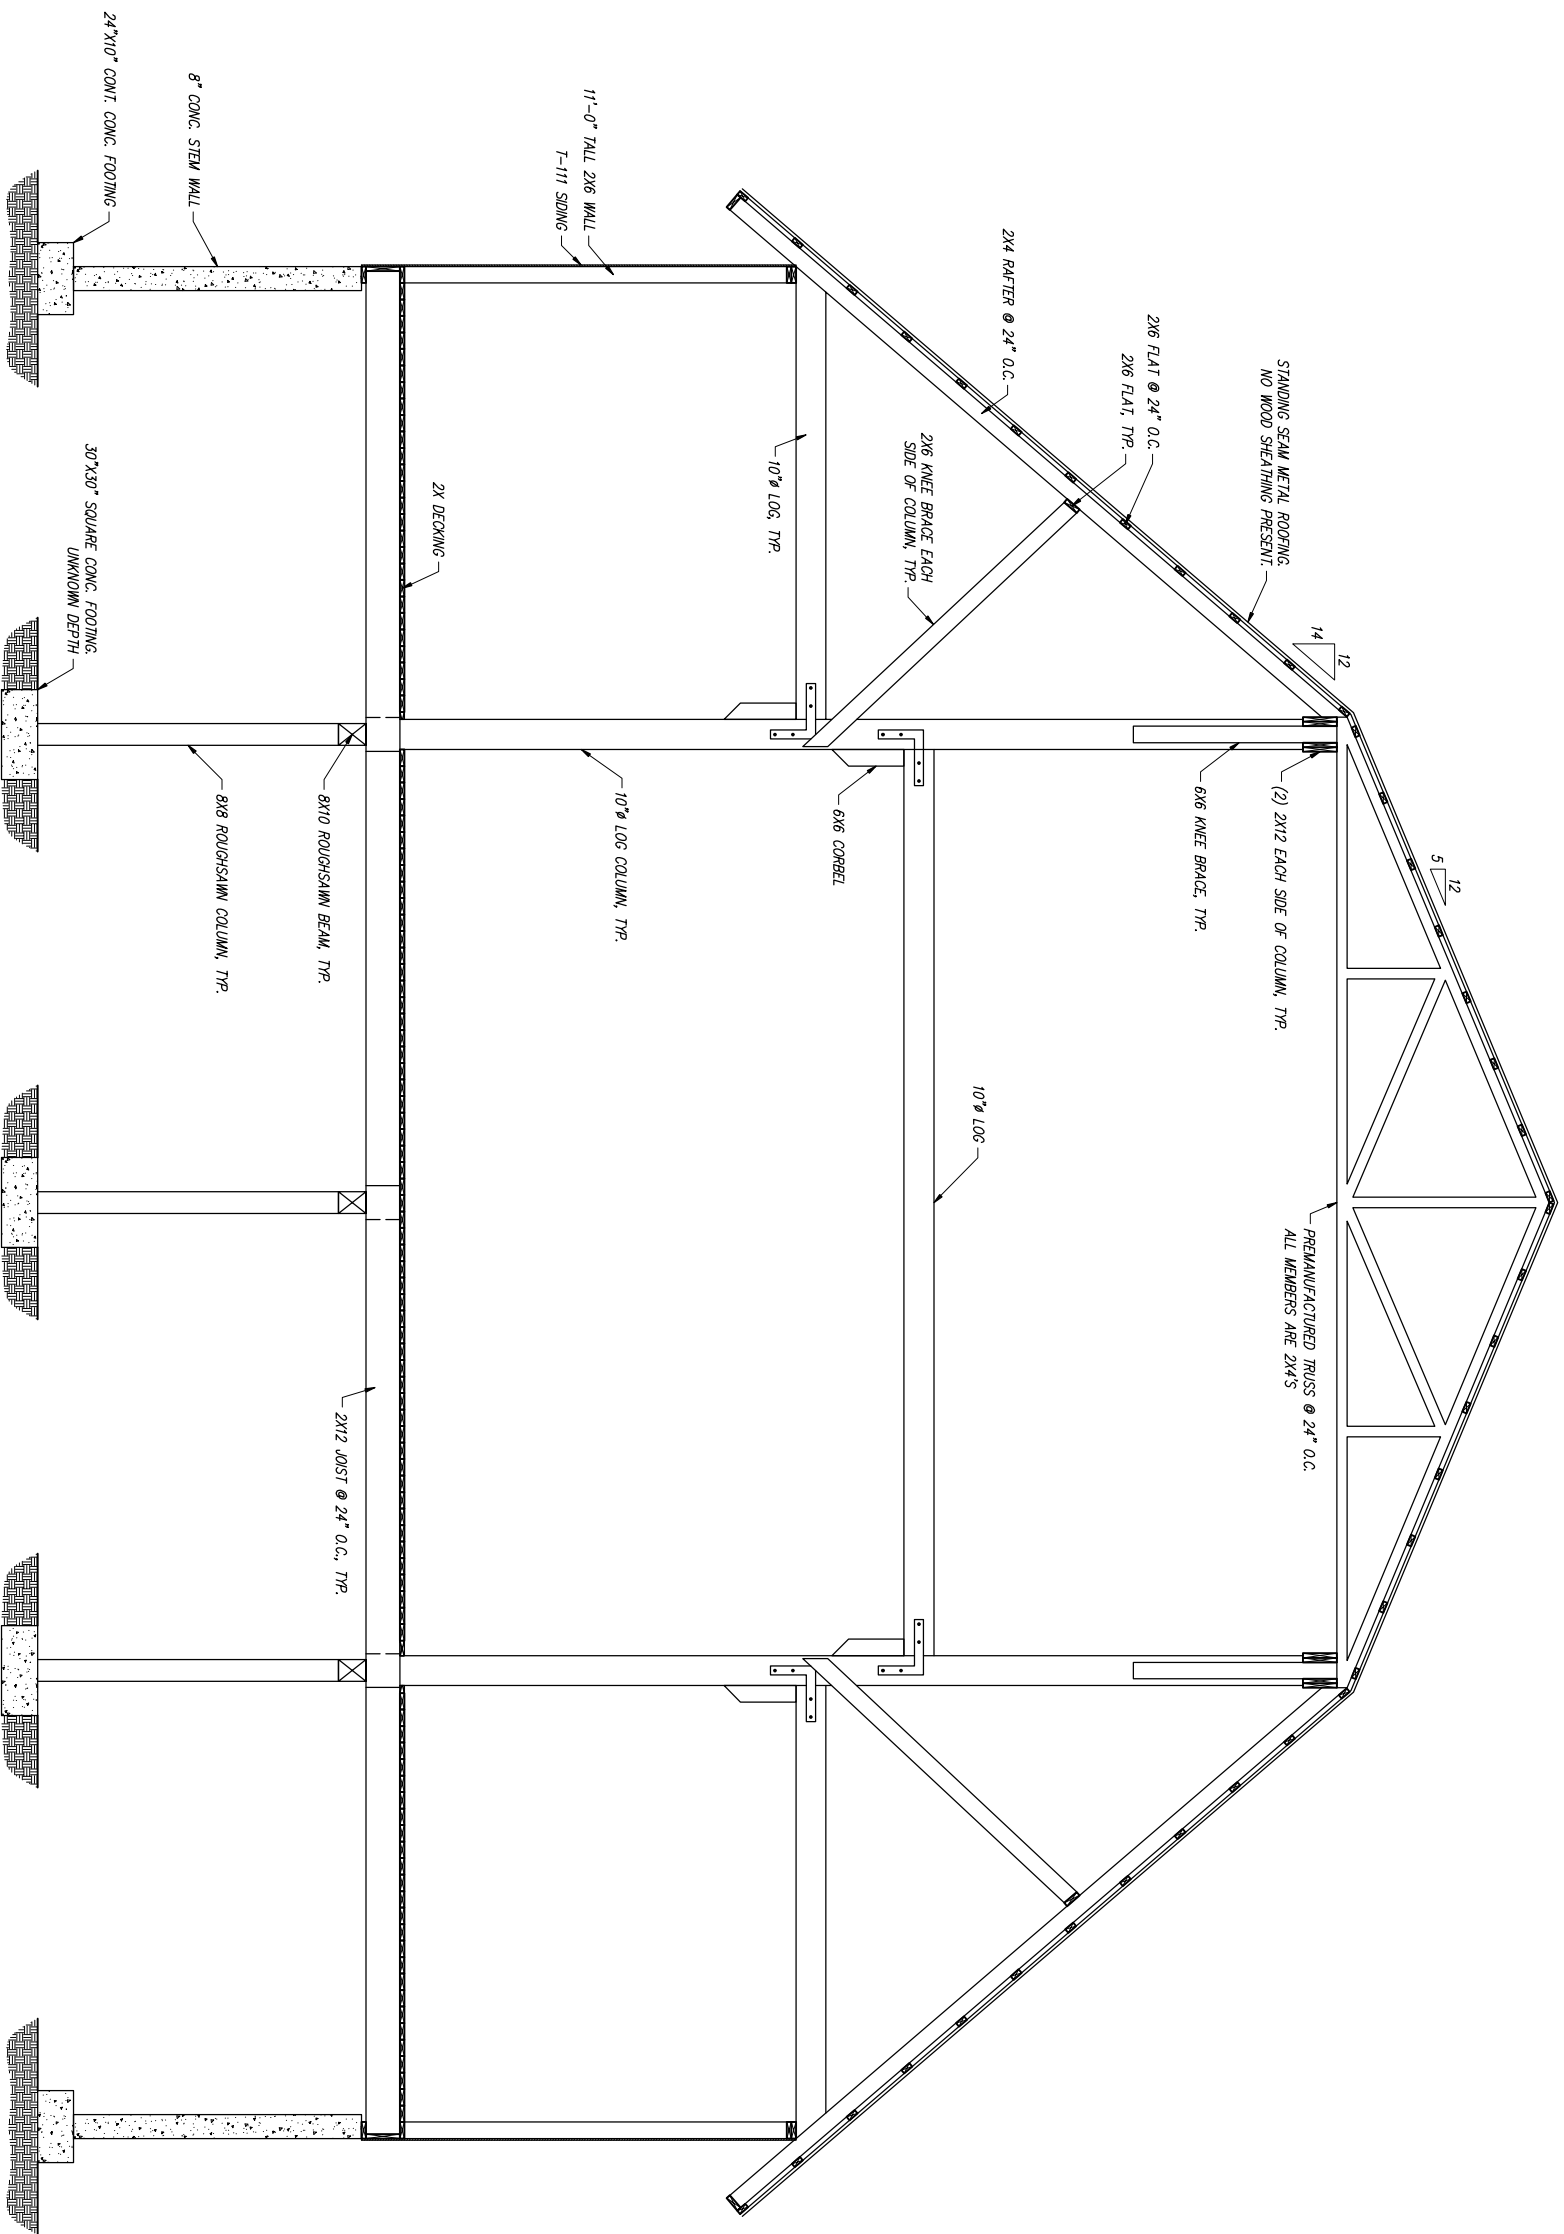

BARN SECTION
Scale: 3/8" = 1'-0"

1:2

SHEET NO.	S4.4	OF	15
SHEETS			

STAR VALLEY RANCH ASSOCIATION AS-BUILT DRAWINGS STAR VALLEY RANCH BARN SECTION

SARGENT
 Sargent Engineers, Inc.
 1290 Arrowhead Plaza Way
 Driggs, Idaho 83422
 Tel. 208 354-4400 • Fax 208 354-4420

Rev.	Date	By	Description