

ADMINISTRATION BUILDING 2ND FLOOR FRAMING PLAN


Scales/1/8" = 1'-0"

DESIGNED BY	Checked By
Proj. Director	Proj. Director
Issue Date	Project No.
Client Ref.	
SHEET NO. S2.3	OF 15 SHEETS

STAR VALLEY RANCH ASSOCIATION  
AS-BUILT DRAWINGS  
STAR VALLEY RANCH  
ADMIN. BLDG. 2ND FLOOR FRAMING

**SARGENT**  
Sargent Engineers, Inc.  
1290 Arrowhead Plaza Way  
Driggs, Idaho 83422  
Tel. 208 354-4400 • Fax 208 354-4420

Rev.	Date	By	Description

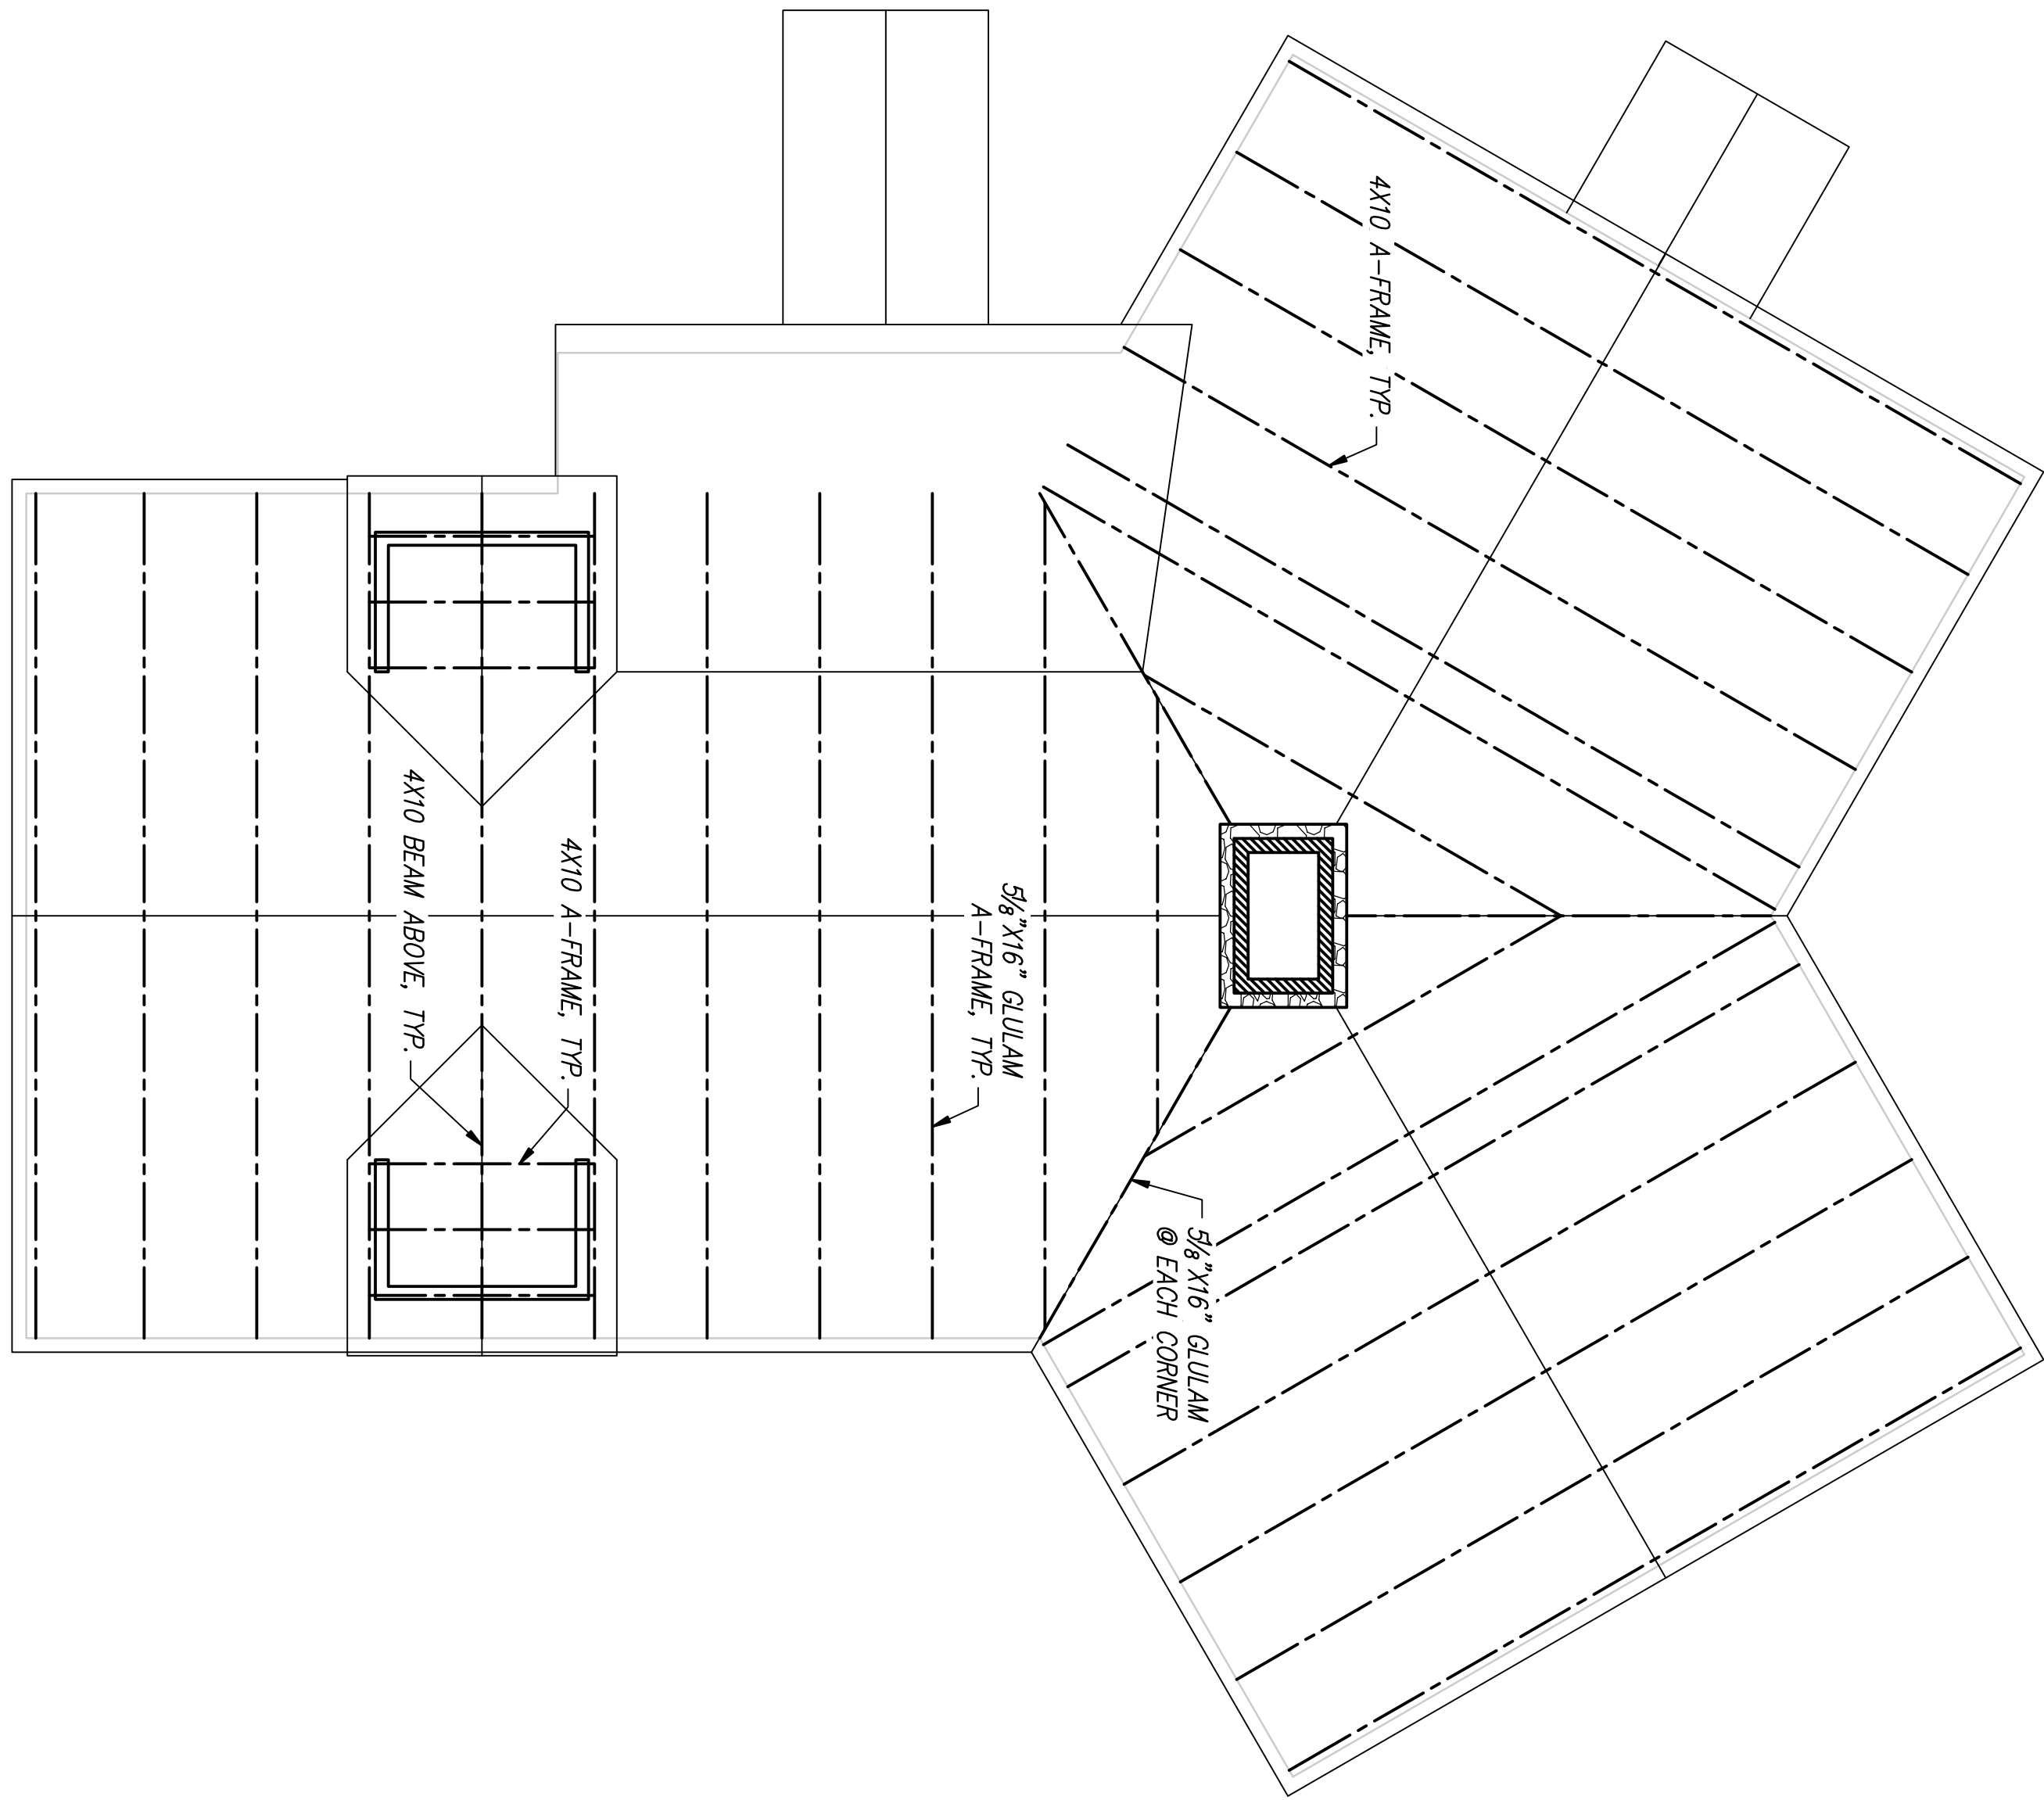

ADMINISTRATION BUILDING ROOF FRAMING PLAN

Scales/1/8" = 1'-0"

DESIGNED BY	Checked By	STAR VALLEY RANCH ASSOCIATION
Proj. Director	Proj. Director	AS-BUILT DRAWINGS
Issue Date: 10/15/2009	Issue Date: 10/15/2009	STAR VALLEY RANCH
Project Ref: D09135.00	Project Ref: D09135.00	ADMIN. BLDG. ROOF FRAMING PLAN
Client Ref:	Client Ref:	


SHEET NO.	15
OF	15
SHEETS	

**SARGENT**  
 Sargent Engineers, Inc.  
 1290 Arrowhead Plaza Way  
 Driggs, Idaho 83422  
 Tel. 208 354-4400 • Fax 208 354-4420

Rev.	Date	By	Description





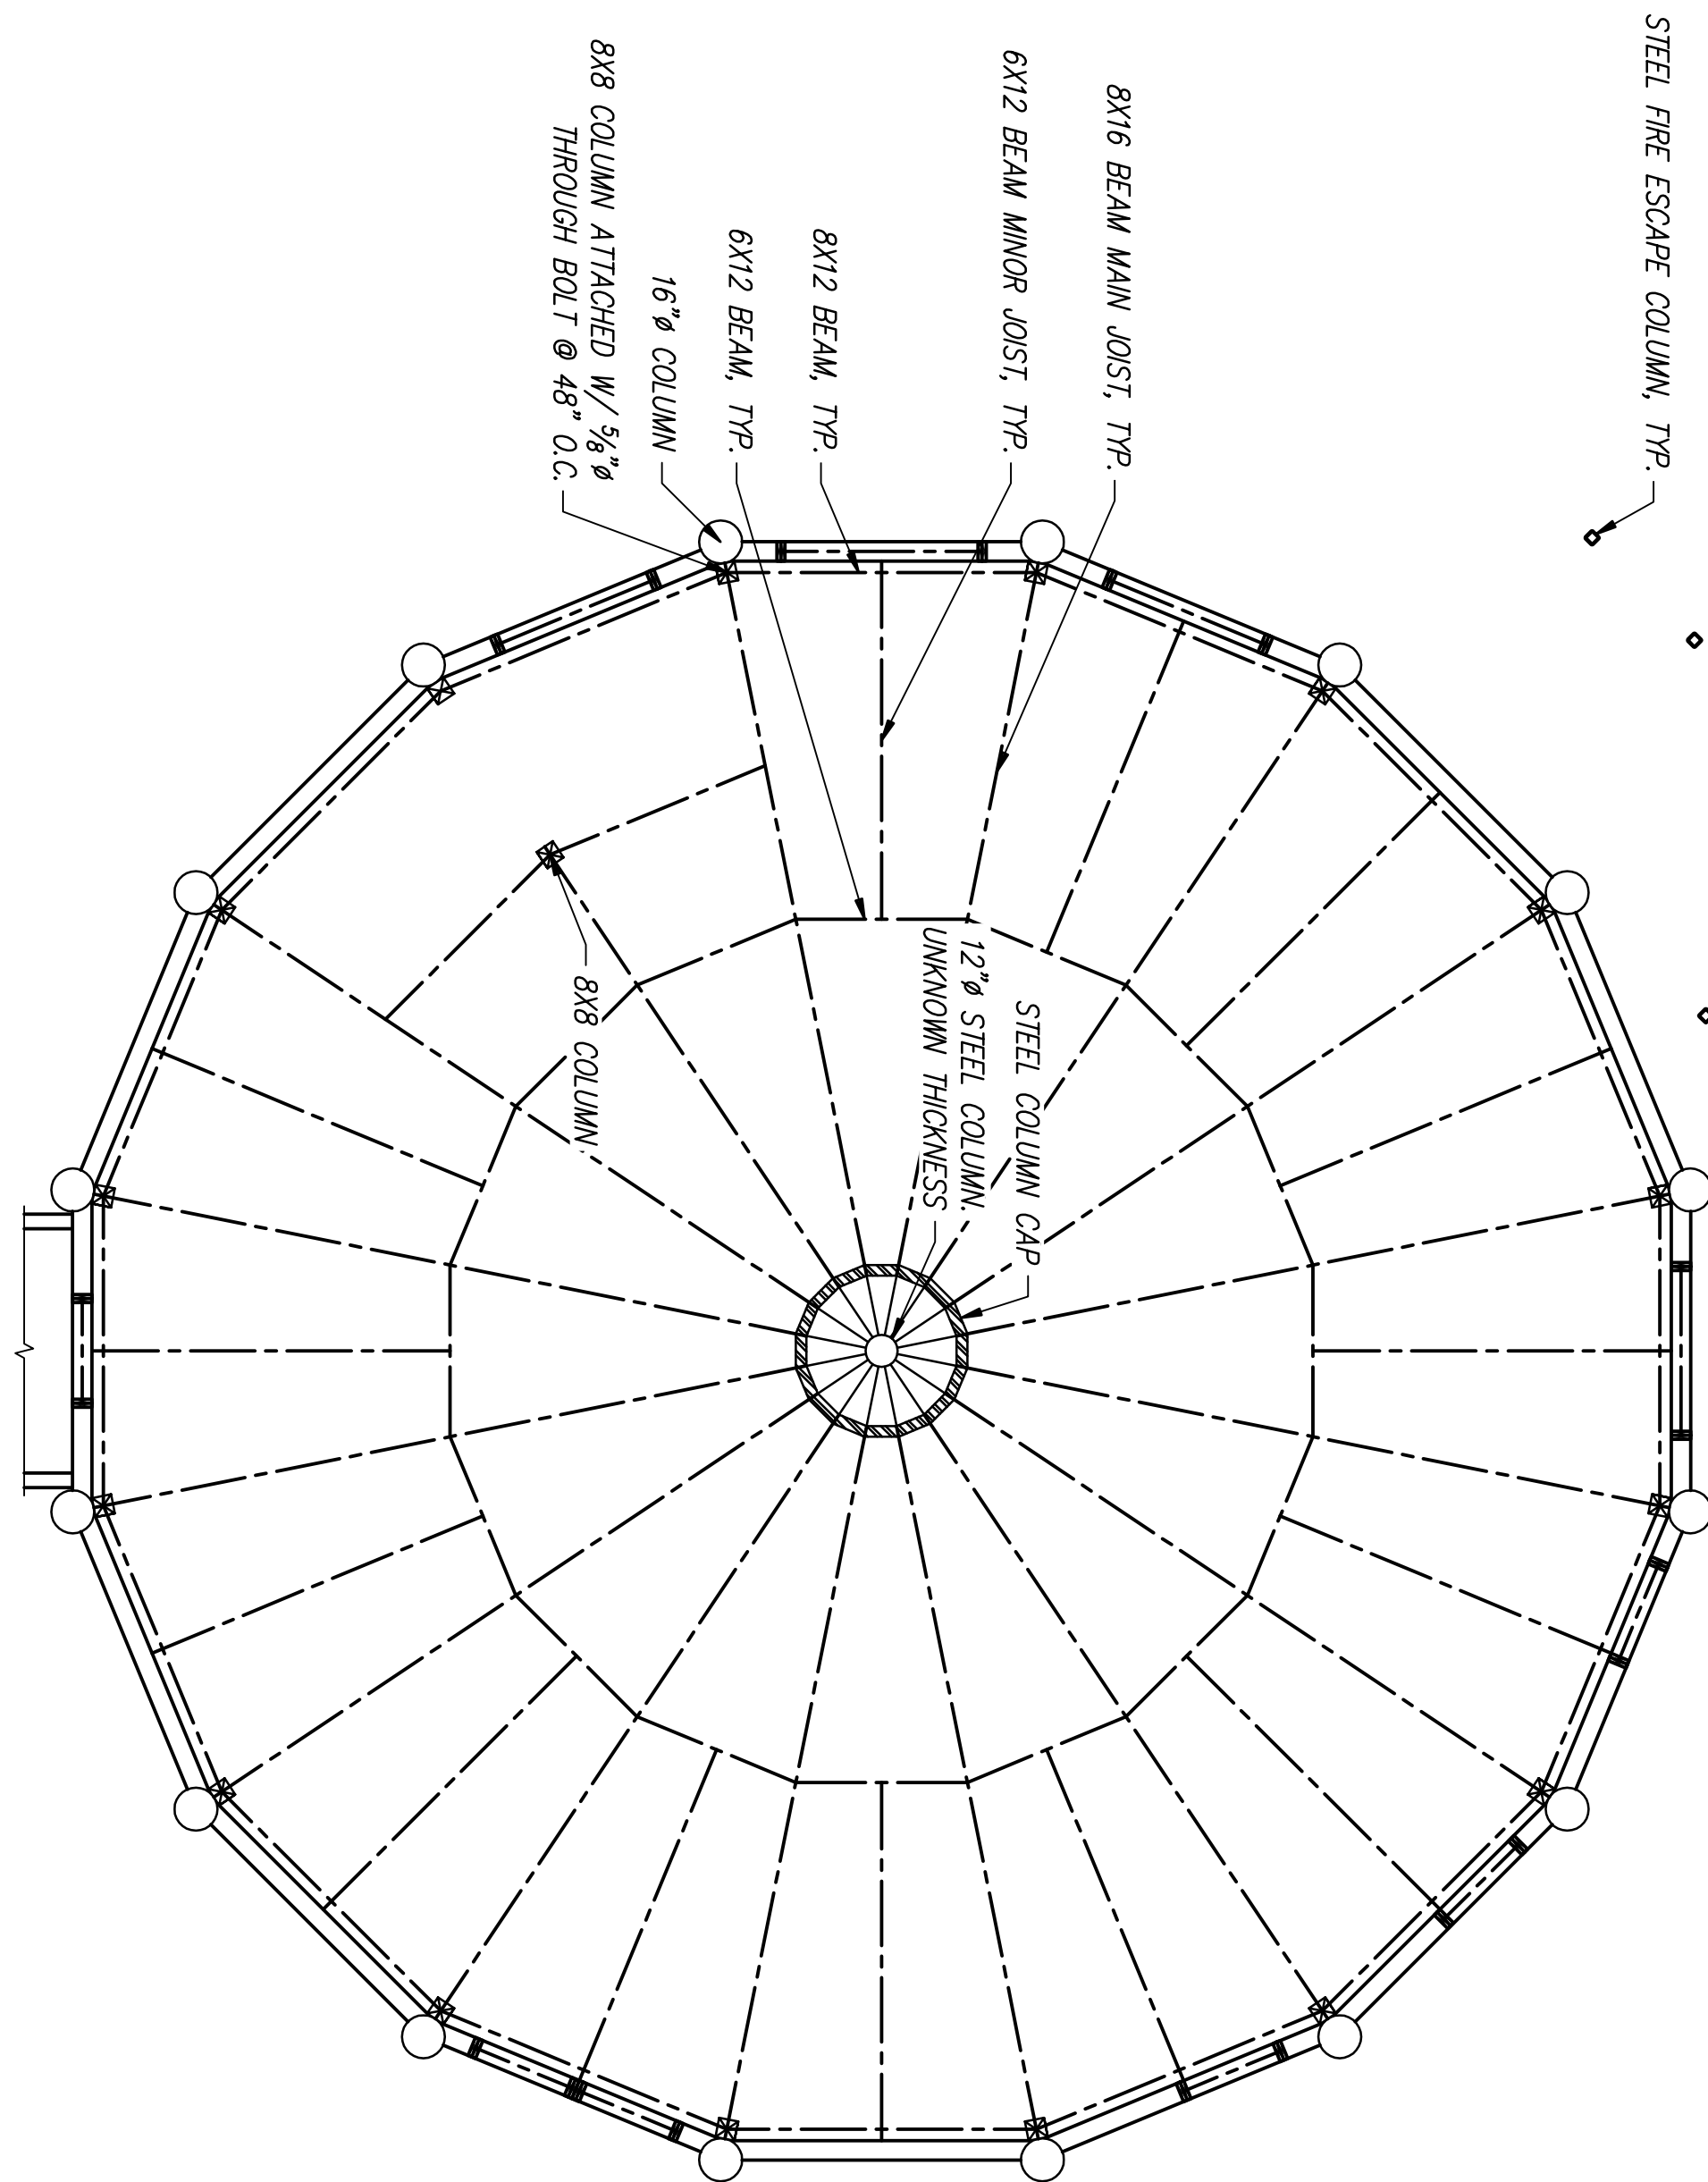

**SILO 2ND FLOOR FRAMING PLAN**


Scales/1/8" = 1'-0"

DESIGNED BY: .	STAR VALLEY RANCH ASSOCIATION
CHECKED BY: .	AS-BUILT DRAWINGS
PROJECT NO.: .	STAR VALLEY RANCH
DATE: .	SILO 2ND FLOOR FRAMING PLAN
ISSUE DATE: 10/15/2009	
PROJECT NO.: 09135.00	
CLIENT REF.: .	

SHEET NO. <b>S3.2</b> OF <b>15</b> SHEETS
---

**SARGENT**  
 Sargent Engineers, Inc.  
 1290 Arrowhead Plaza Way  
 Driggs, Idaho 83422  
 Tel. 208 354-4400 • Fax 208 354-4420

Rev.	Date	By	Description

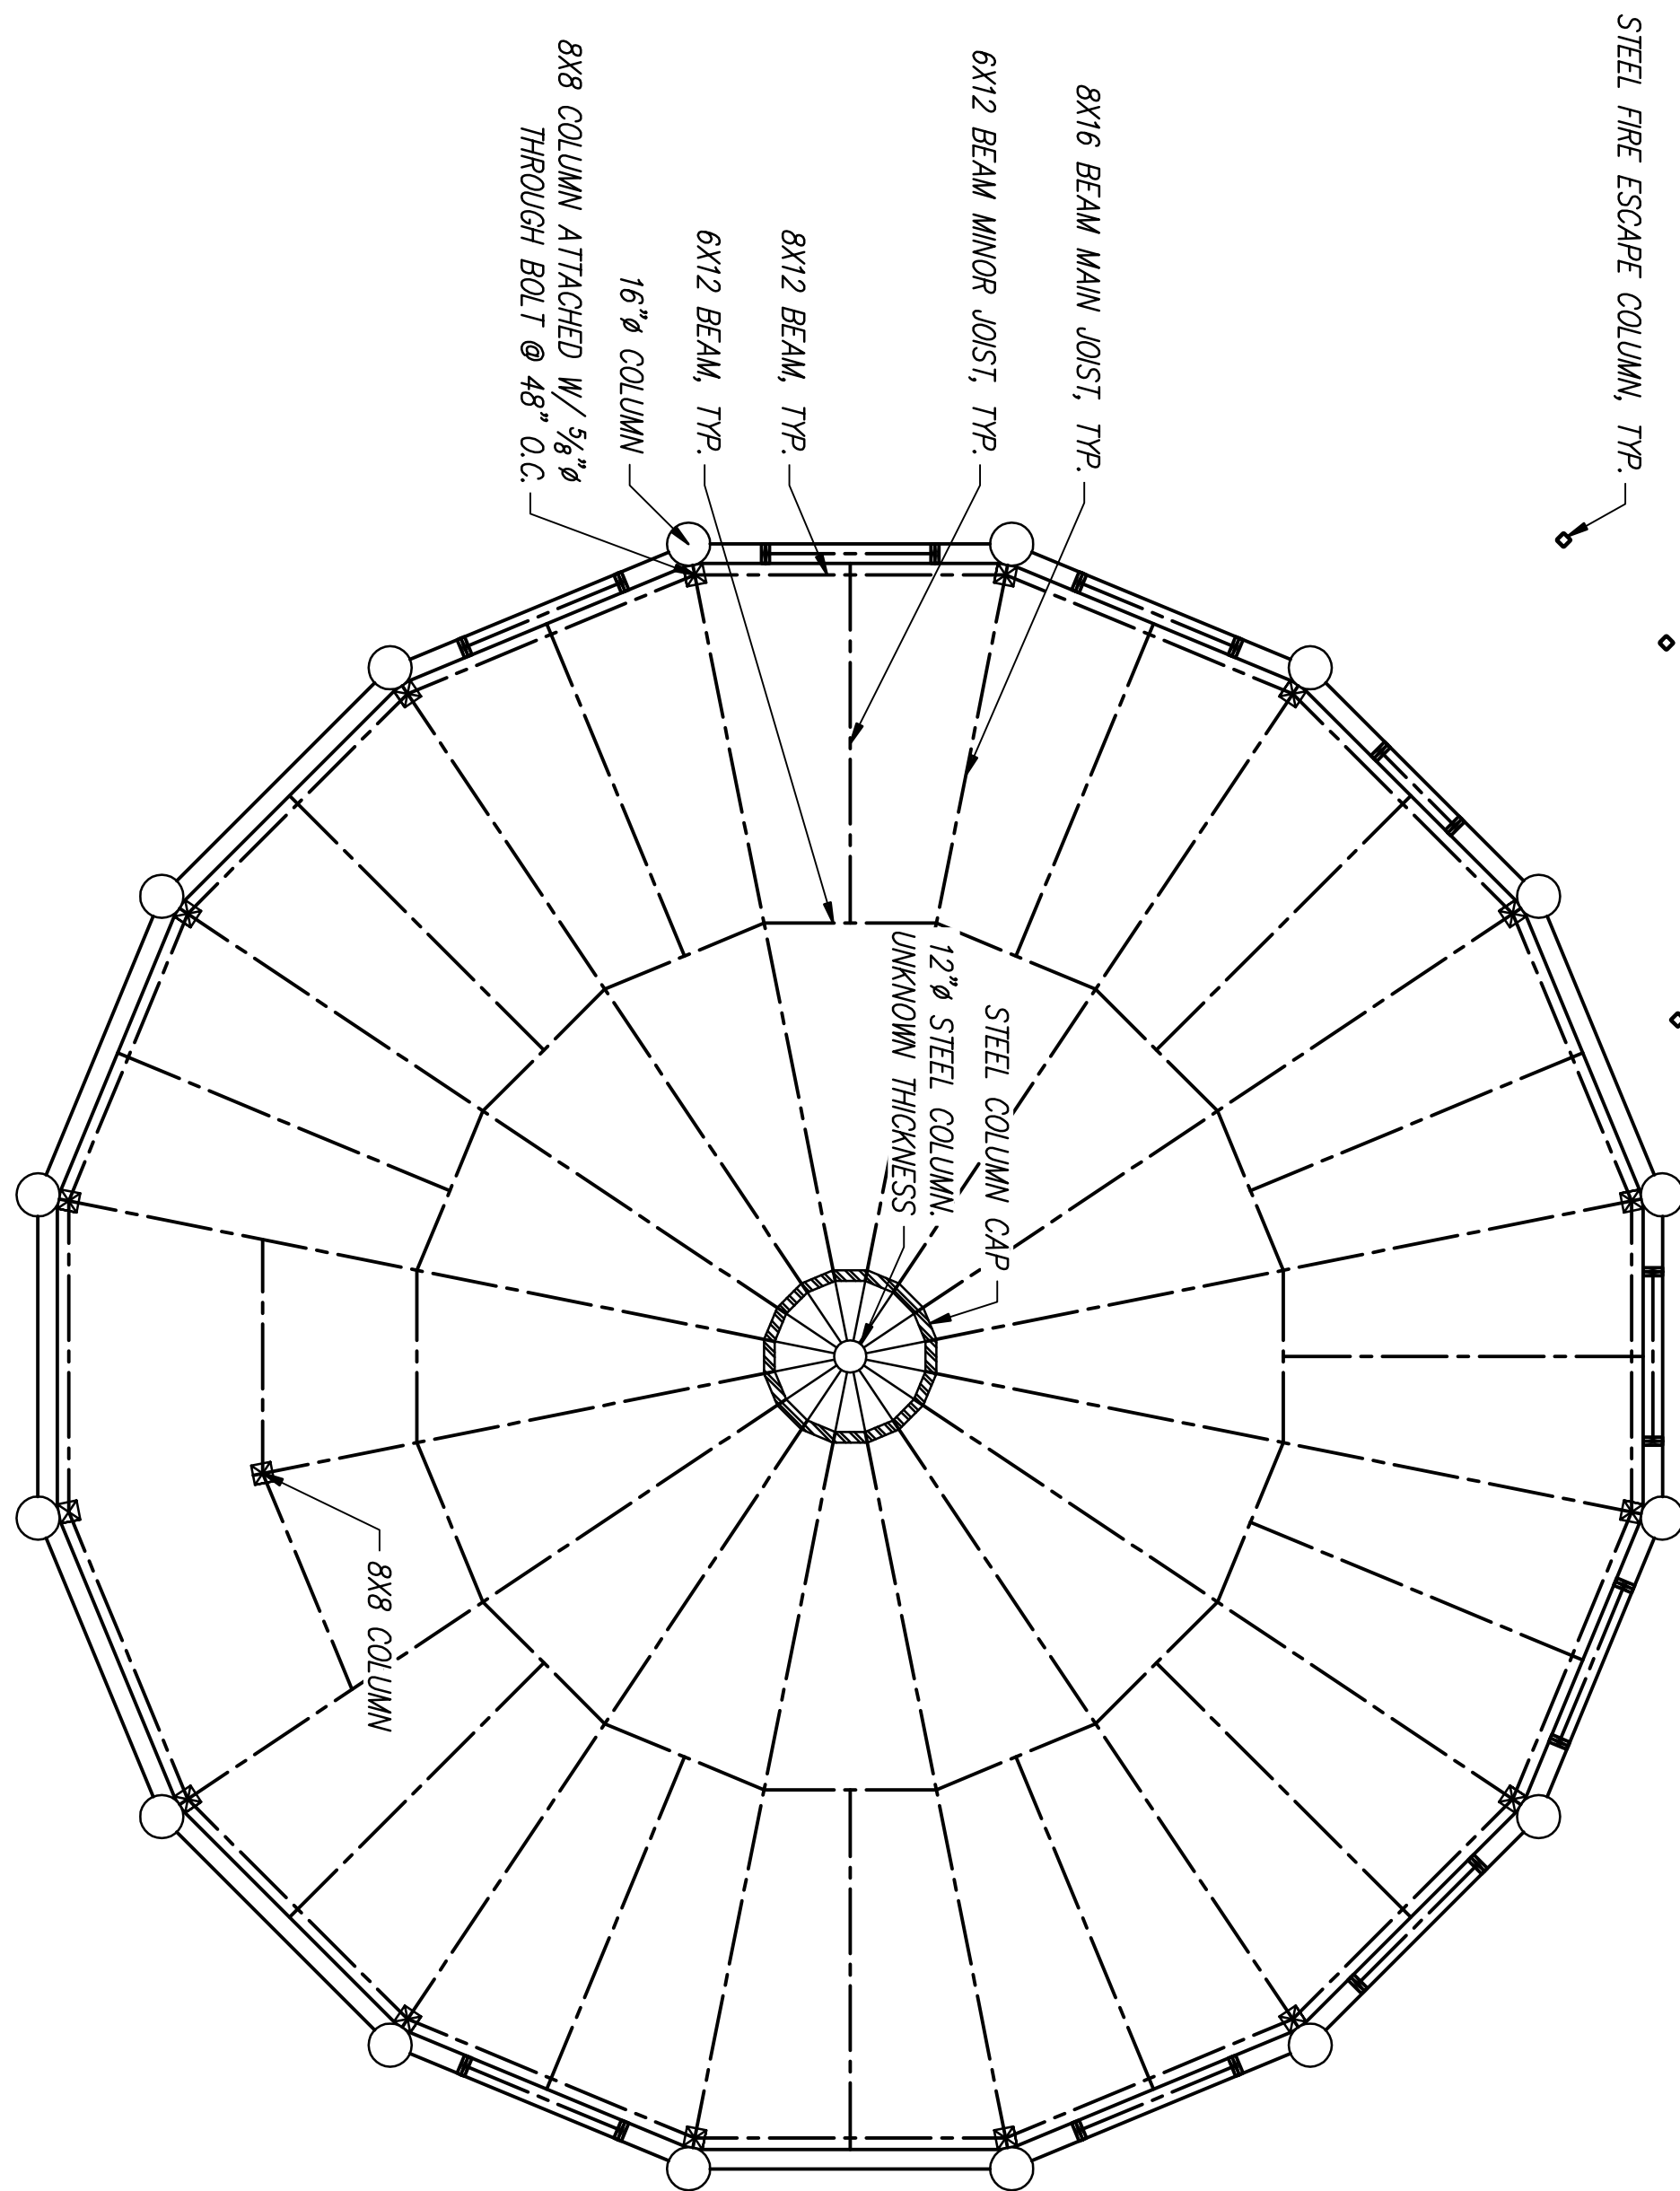

SILO 3RD FLOOR FRAMING PLAN

Scales/16" = 1'-0"


DESIGNED BY	CHKD BY	DATE
DRN BY	APP'D BY	
ISSUED BY		
PROJECT NO.		
CLIENT		
SHEET NO.	15	OF 15 SHEETS

STAR VALLEY RANCH ASSOCIATION  
AS-BUILT DRAWINGS  
STAR VALLEY RANCH  
SILO 3RD FLOOR FRAMING PLAN

**SARGENT**  
Sargent Engineers, Inc.  
1290 Arrowhead Plaza Way  
Driggs, Idaho 83422  
Tel. 208 354-4400 • Fax 208 354-4420

Rev.	Date	By	Description



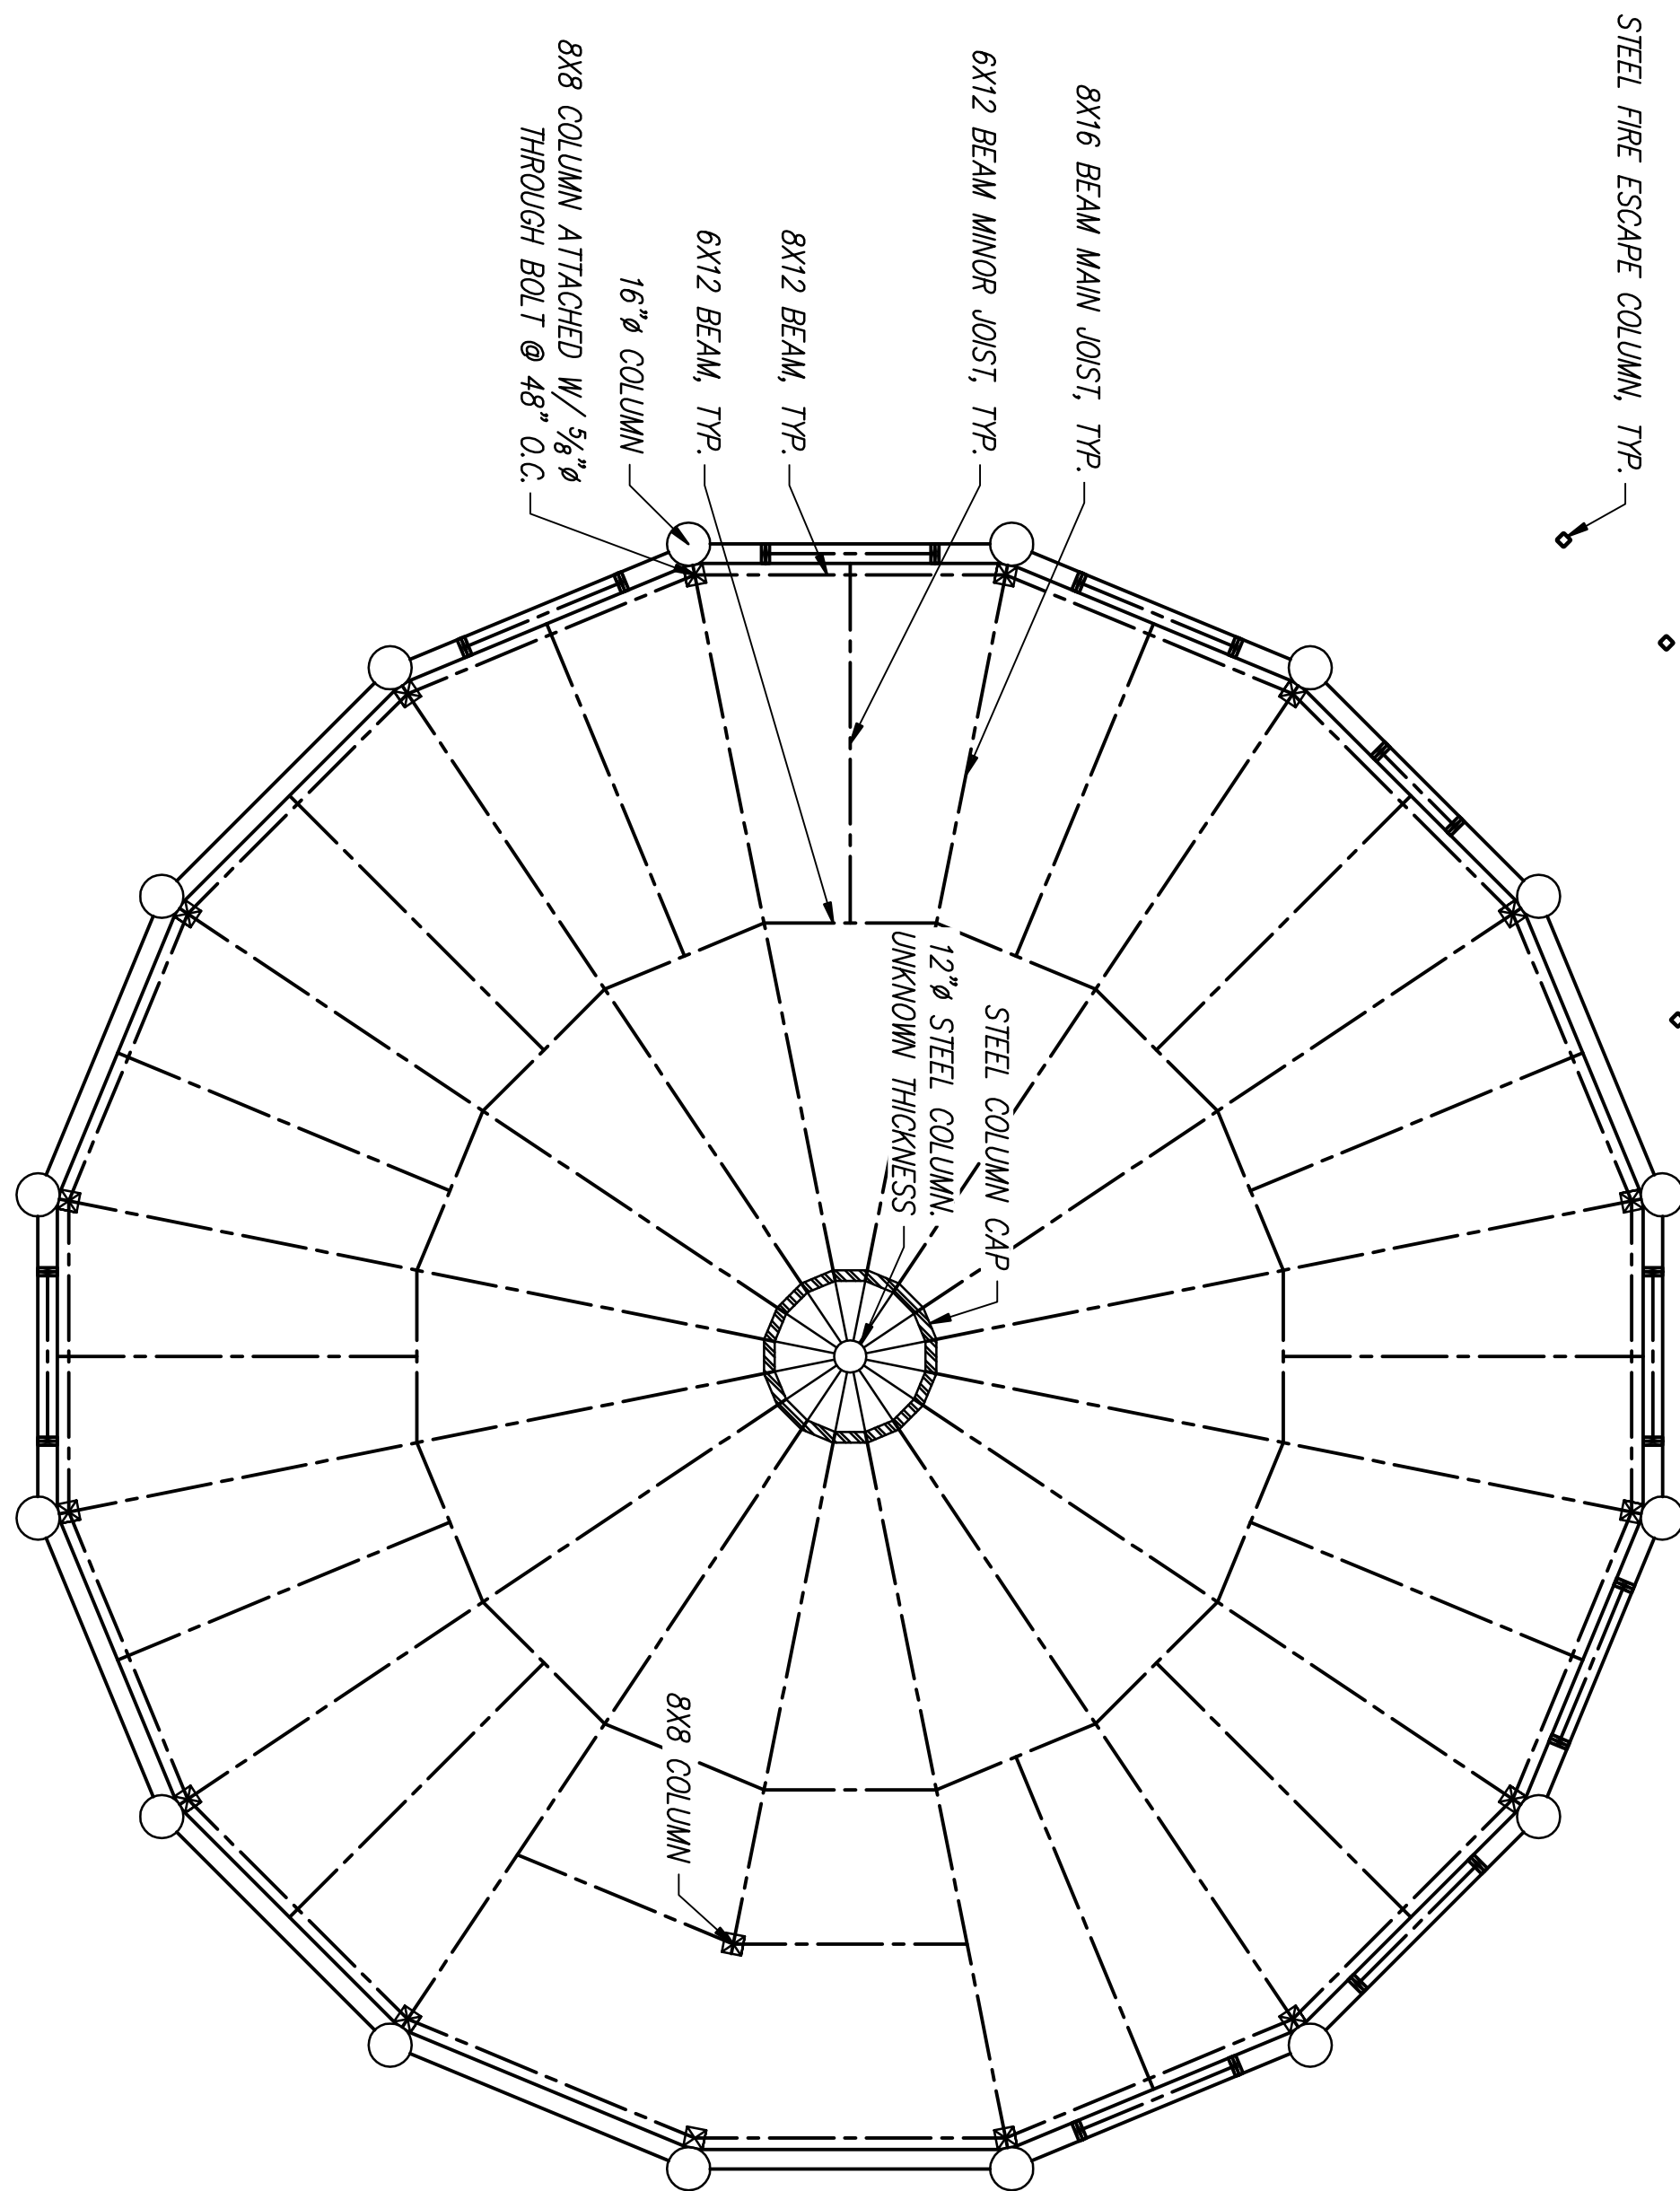

SILO 4TH FLOOR FRAMING PLAN


Scales/16" = 1'-0"

DESIGNED BY	CHKD BY	DATE
PROJECT NO.	ISSUE NO.	DATE
PROJECT NAME	CLIENT NAME	CLIENT ADDR.
SHEET NO.	OF	SHEETS
S3.4	15	

STAR VALLEY RANCH ASSOCIATION  
AS-BUILT DRAWINGS  
STAR VALLEY RANCH  
SILO 4TH FLOOR FRAMING PLAN

**SARGENT**  
Sargent Engineers, Inc.  
1290 Arrowhead Plaza Way  
Driggs, Idaho 83422  
Tel. 208 354-4400 • Fax 208 354-4420

Rev.	Date	By	Description

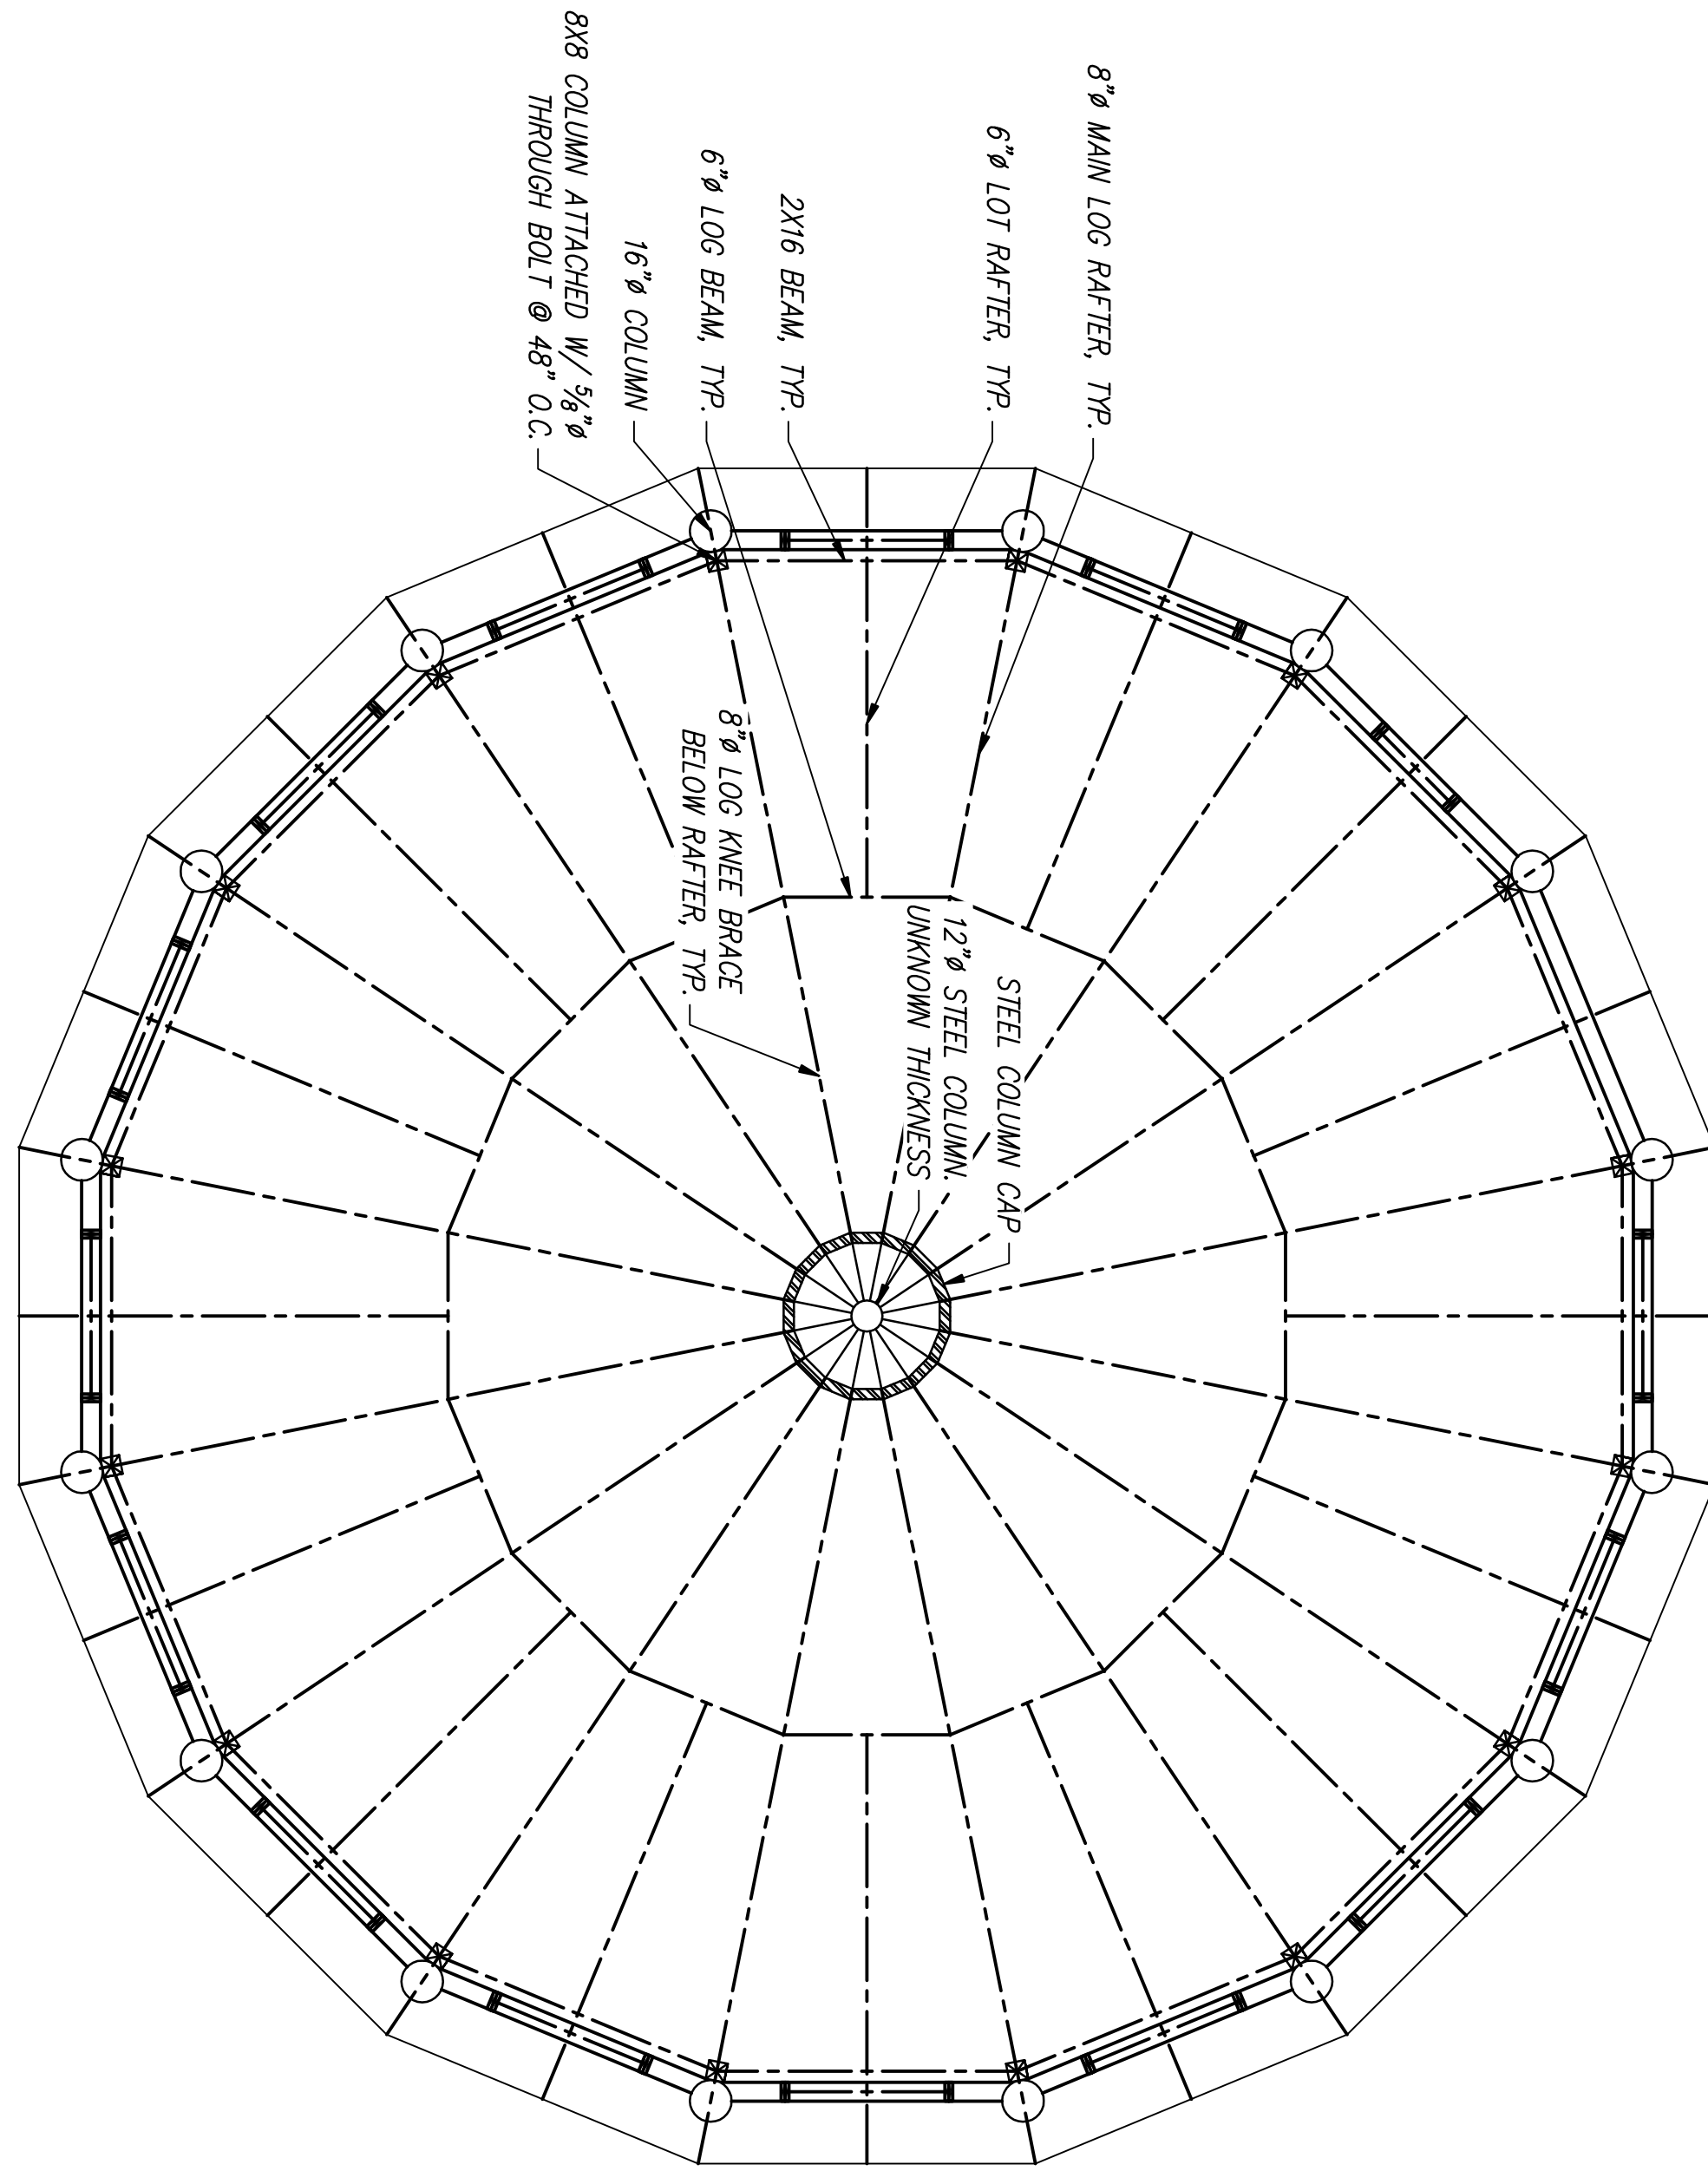


**SILO ROOF FRAMING PLAN**  
Scale: 1/8" = 1'-0"

SHEET NO. <b>S3.5</b>	OF <b>15</b>	SHEETS	Designed By: .
			Checked By: .
			Proj. Director: .
			Drafter: .
			Issue Date: .
			Project No.: .
			Client Ref.: .

STAR VALLEY RANCH ASSOCIATION  
AS-BUILT DRAWINGS  
STAR VALLEY RANCH  
SILO ROOF FRAMING PLAN

**SARGENT**  
Sargent Engineers, Inc.  
1290 Arrowhead Plaza Way  
Driggs, Idaho 83422  
Tel. 208 354-4400 • Fax 208 354-4420

Rev.	Date	By	Description

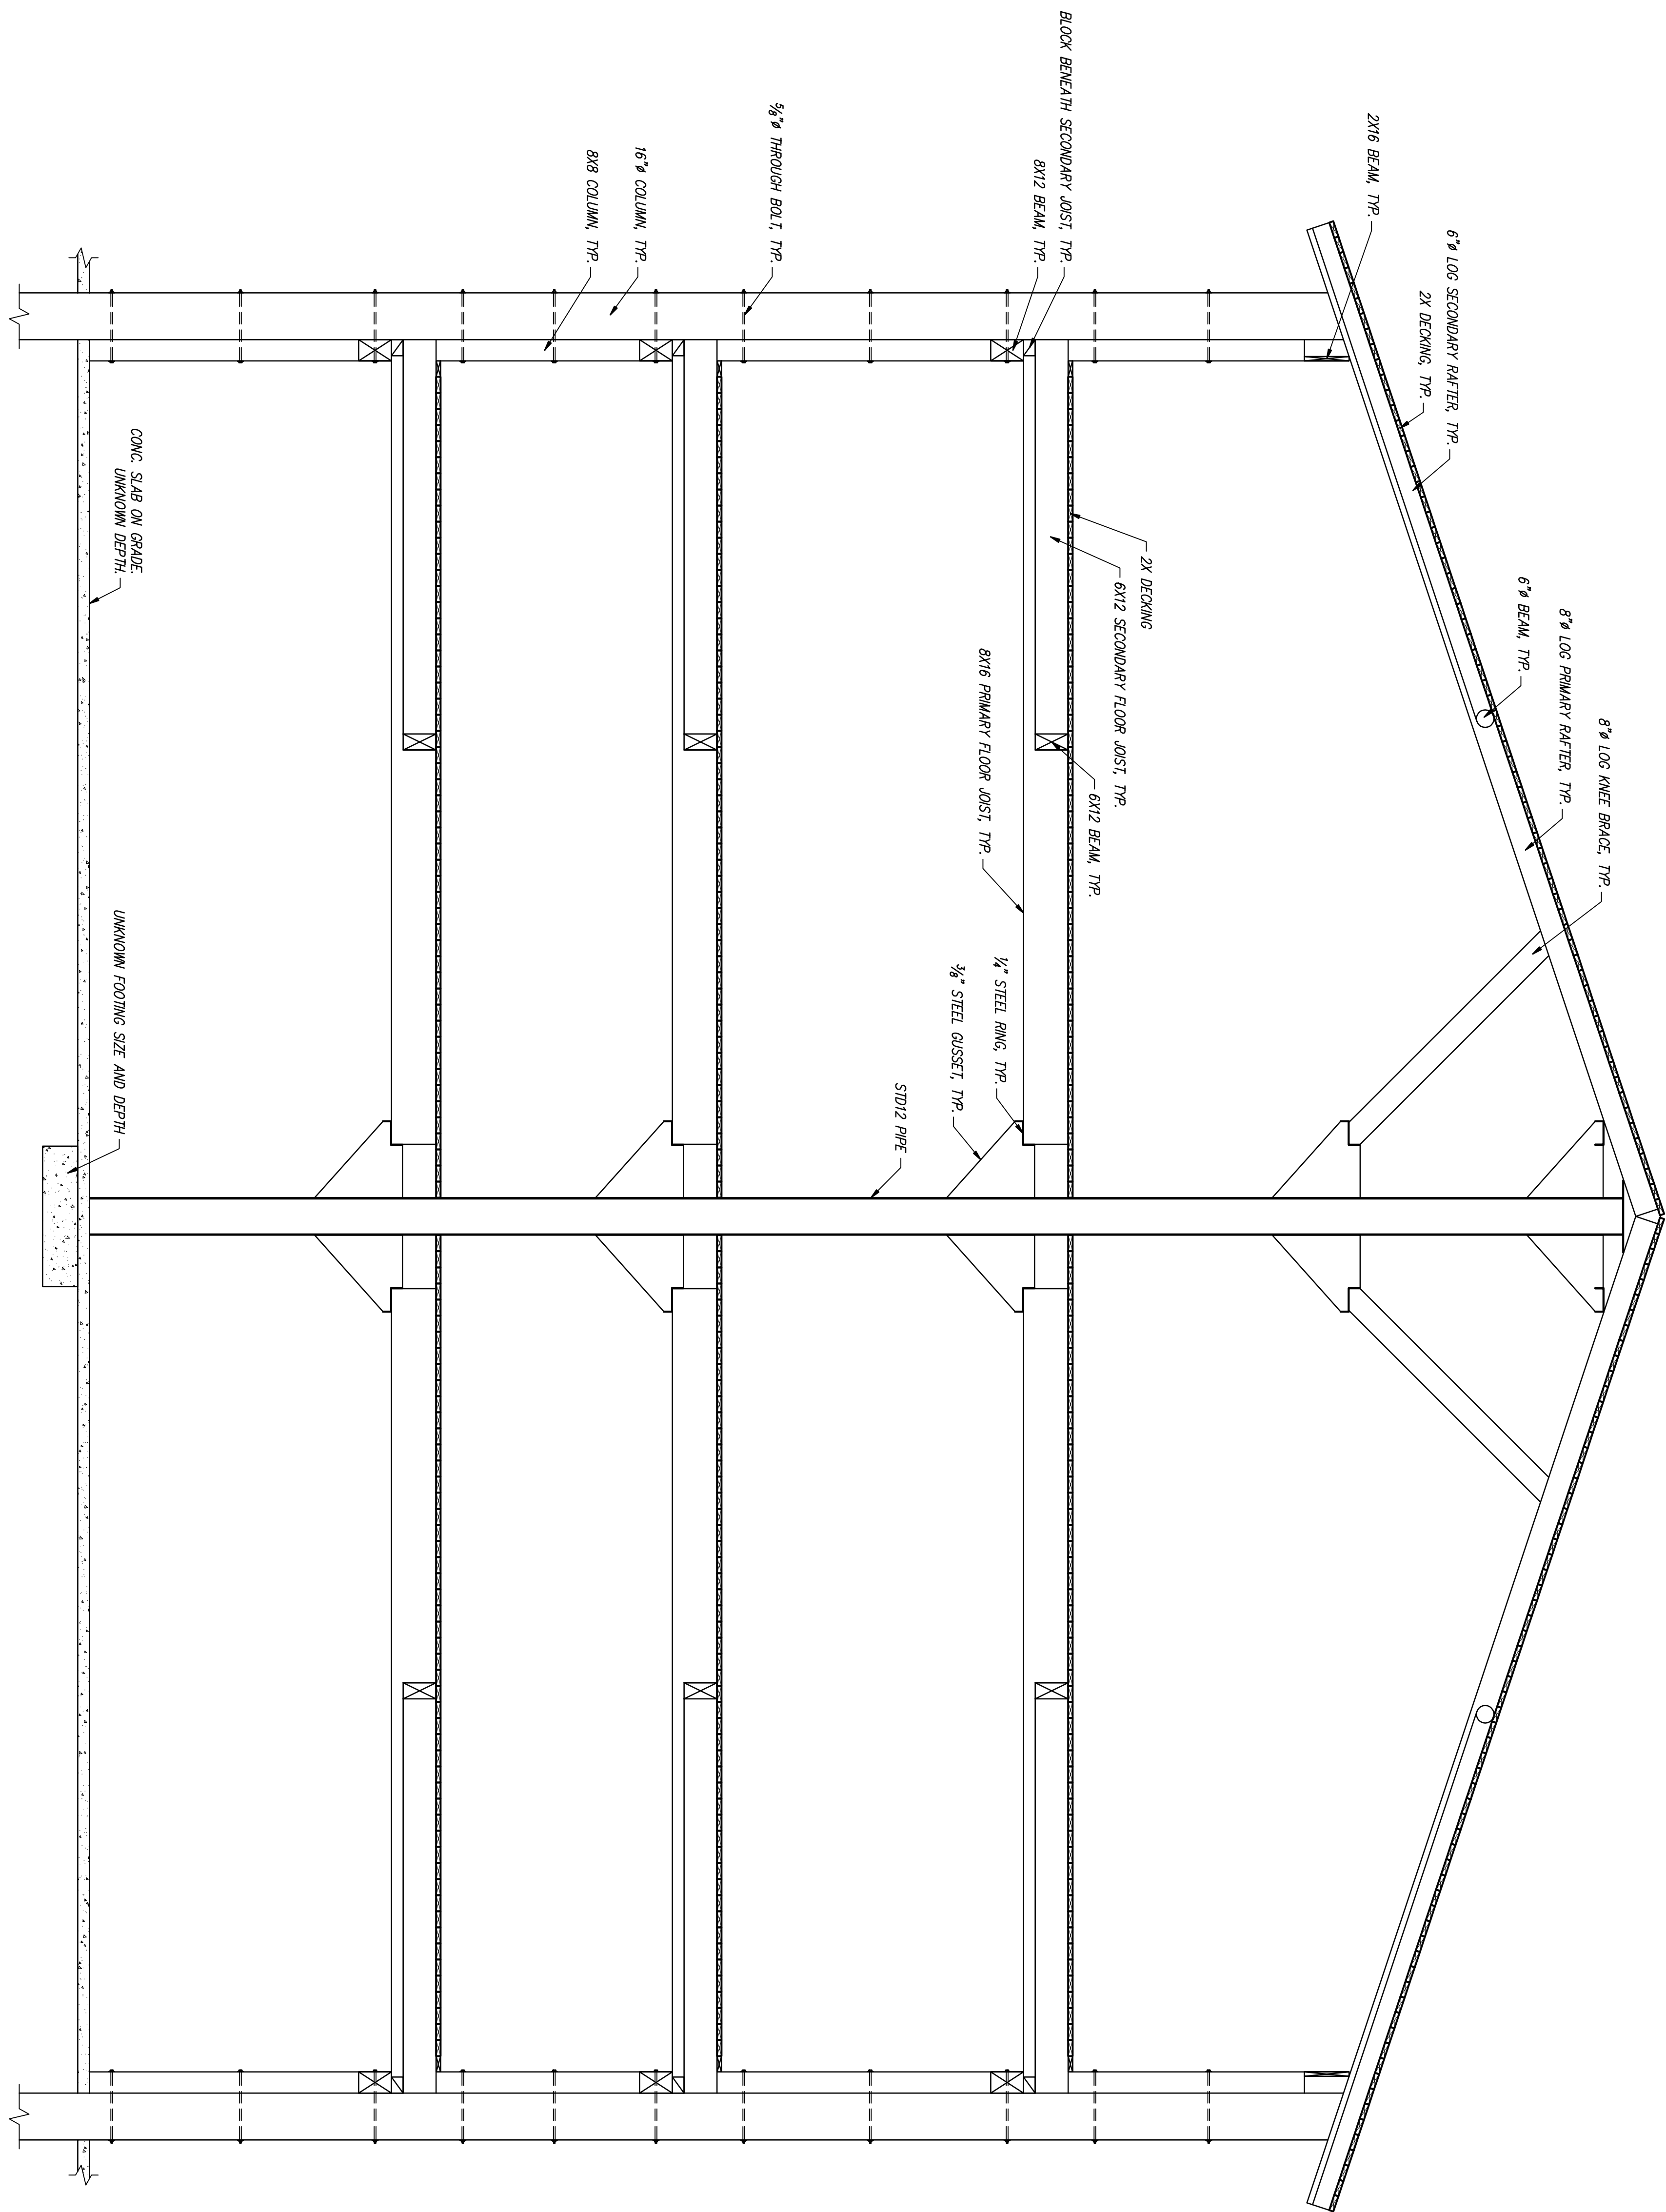


**SILO SECTION**  
Scale: 1/8" = 1'-0"

DESIGNED BY: .	CHECKED BY: .
PROJECT NO.:	DATE: .
ISSUE NO.:	ISSUE DATE: .
CLIENT: .	PROJECT: .
SHEET NO. <b>S3.5</b> OF <b>15</b> SHEETS	

STAR VALLEY RANCH ASSOCIATION  
AS-BUILT DRAWINGS  
STAR VALLEY RANCH  
SILO SECTION

**SARGENT**  
Sargent Engineers, Inc.  
1290 Arrowhead Plaza Way  
Driggs, Idaho 83422  
Tel. 208 354-4400 • Fax 208 354-4420

Rev.	Date	By	Description

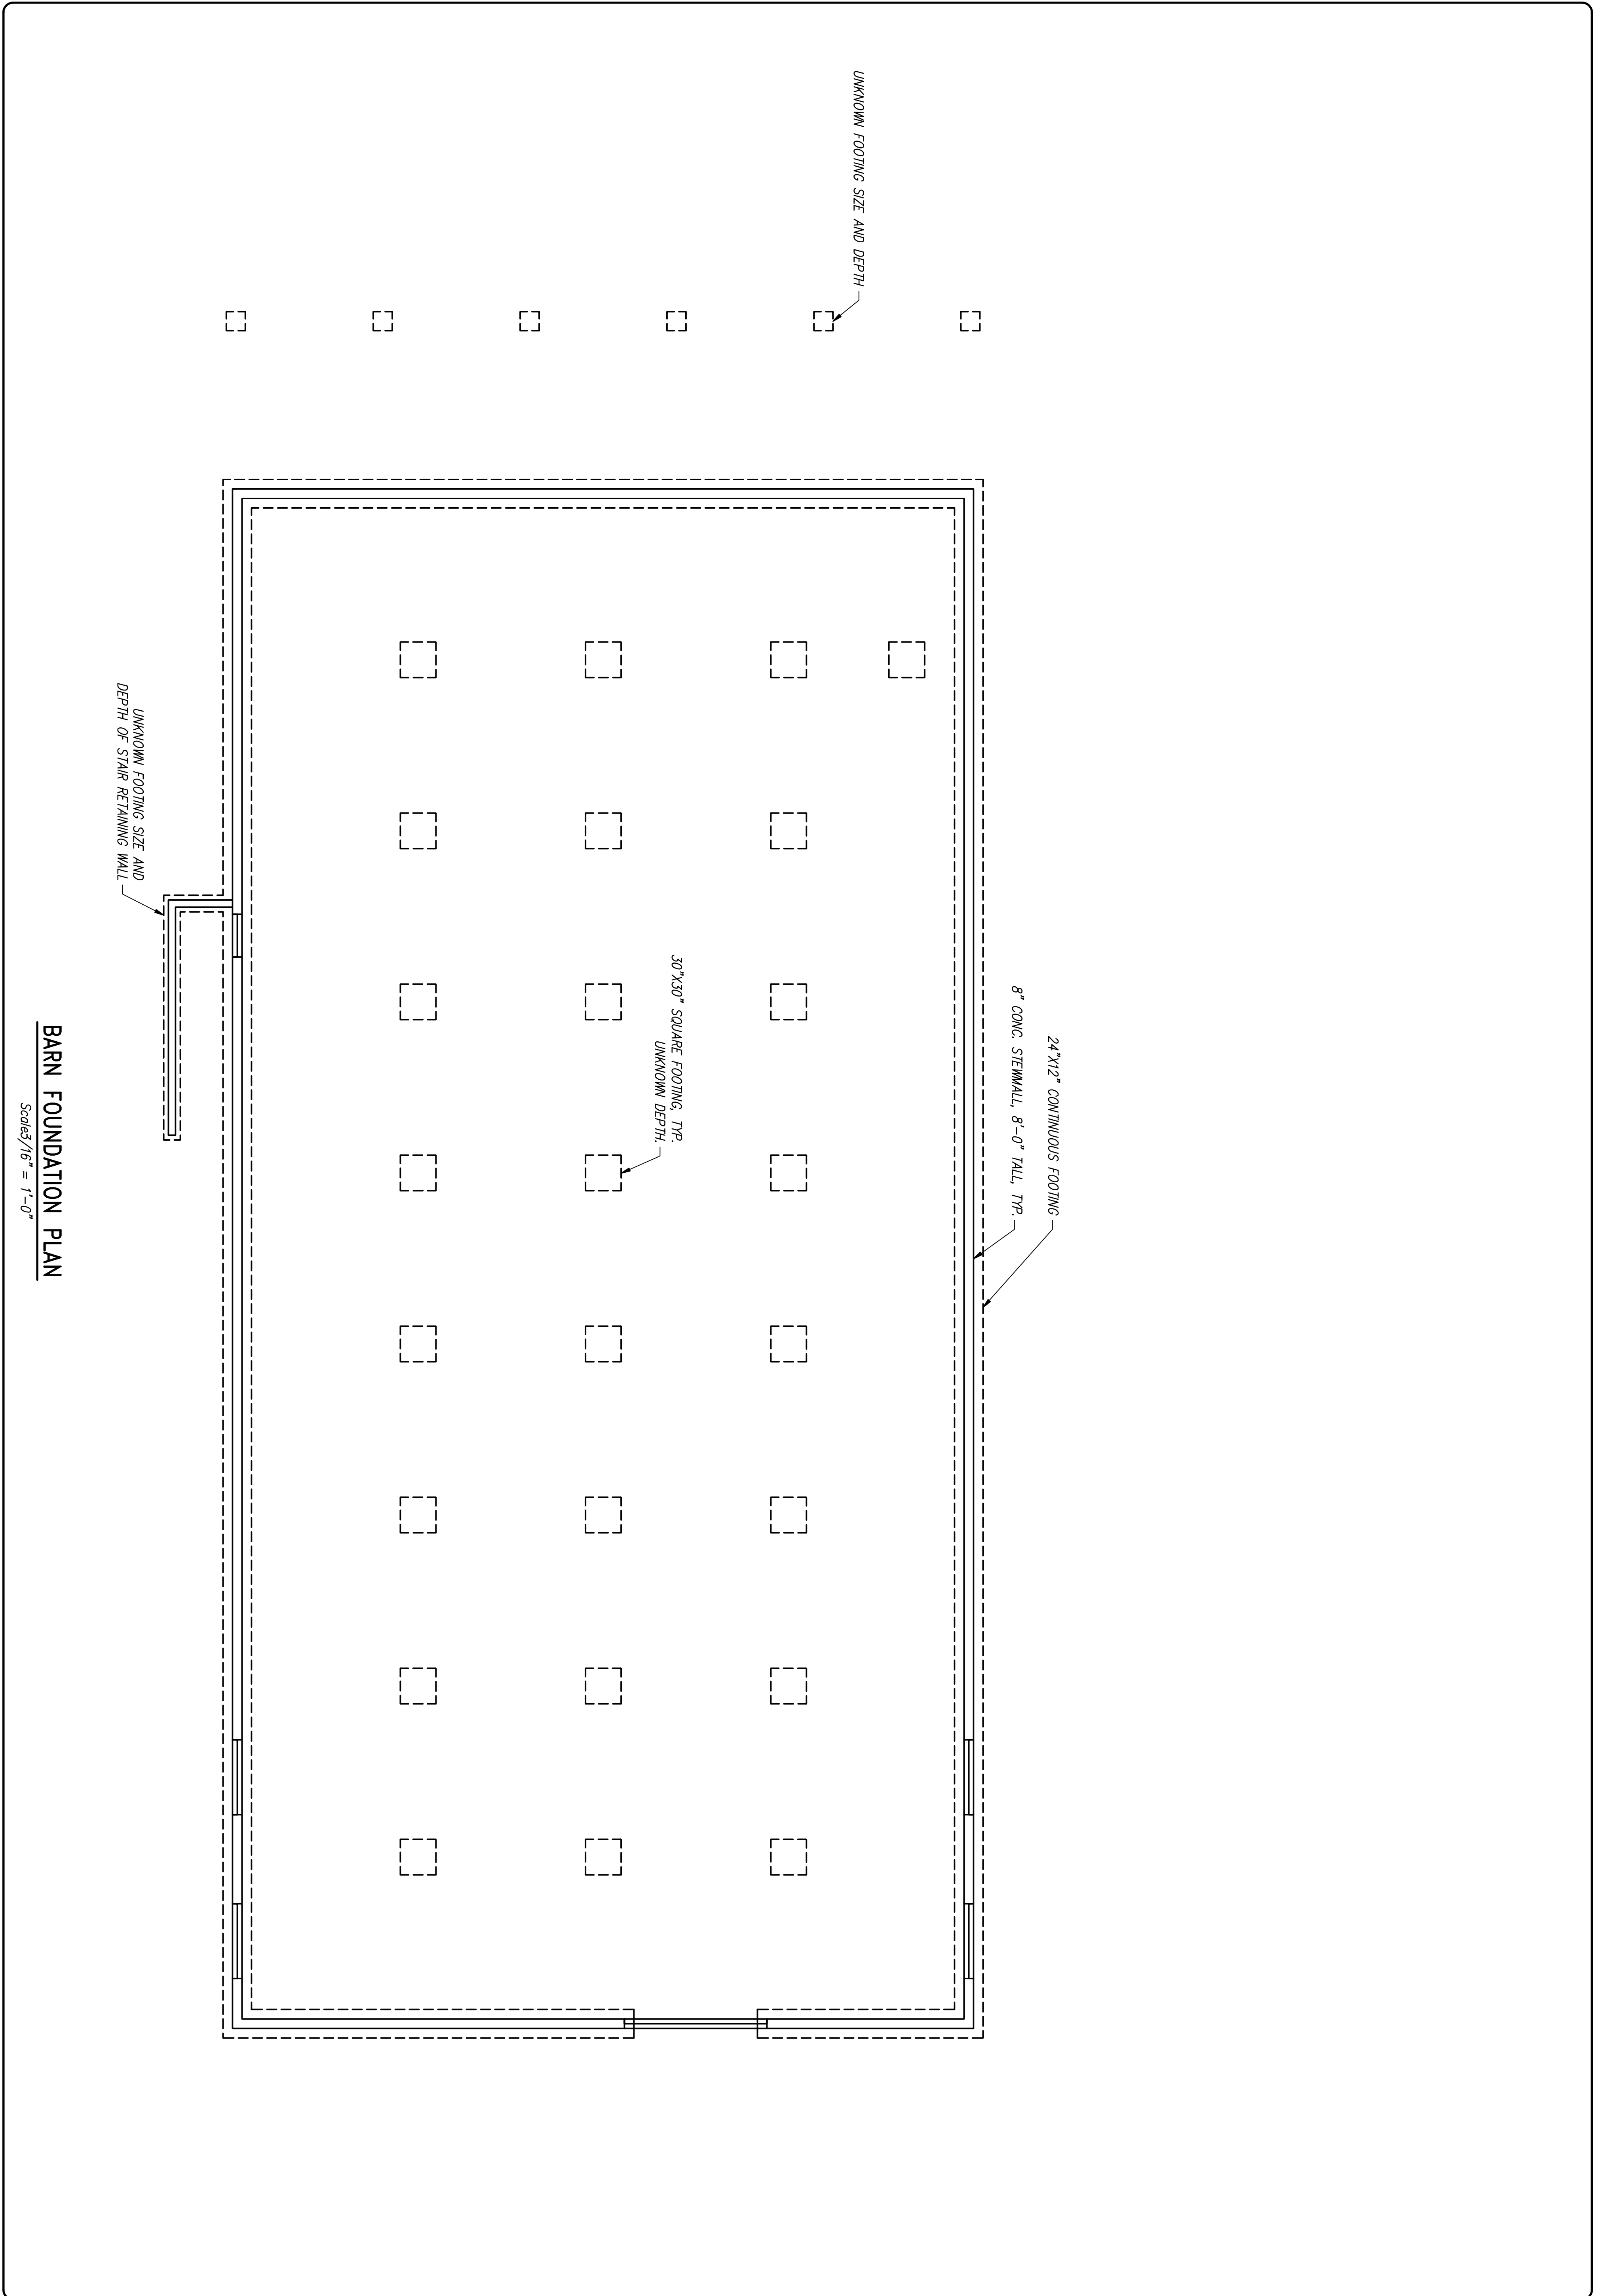

**BARN FOUNDATION PLAN**


Scales/16" = 1'-0"

SHEET NO. <b>S4.1</b>	OF <b>15</b>	SHEETS	Designed By: .
			Checked By: .
			Proj. Director: MHH
			Printer: MHH
			Issue Date: 10/15/2009
			Project No.: D09135.00
			Client Ref.: .

STAR VALLEY RANCH ASSOCIATION  
AS-BUILT DRAWINGS  
STAR VALLEY RANCH  
BARN FOUNDATION PLAN

**SARGENT**  
Sargent Engineers, Inc.  
1290 Arrowhead Plaza Way  
Driggs, Idaho 83422  
Tel. 208 354-4400 • Fax 208 354-4420

Rev.	Date	By	Description

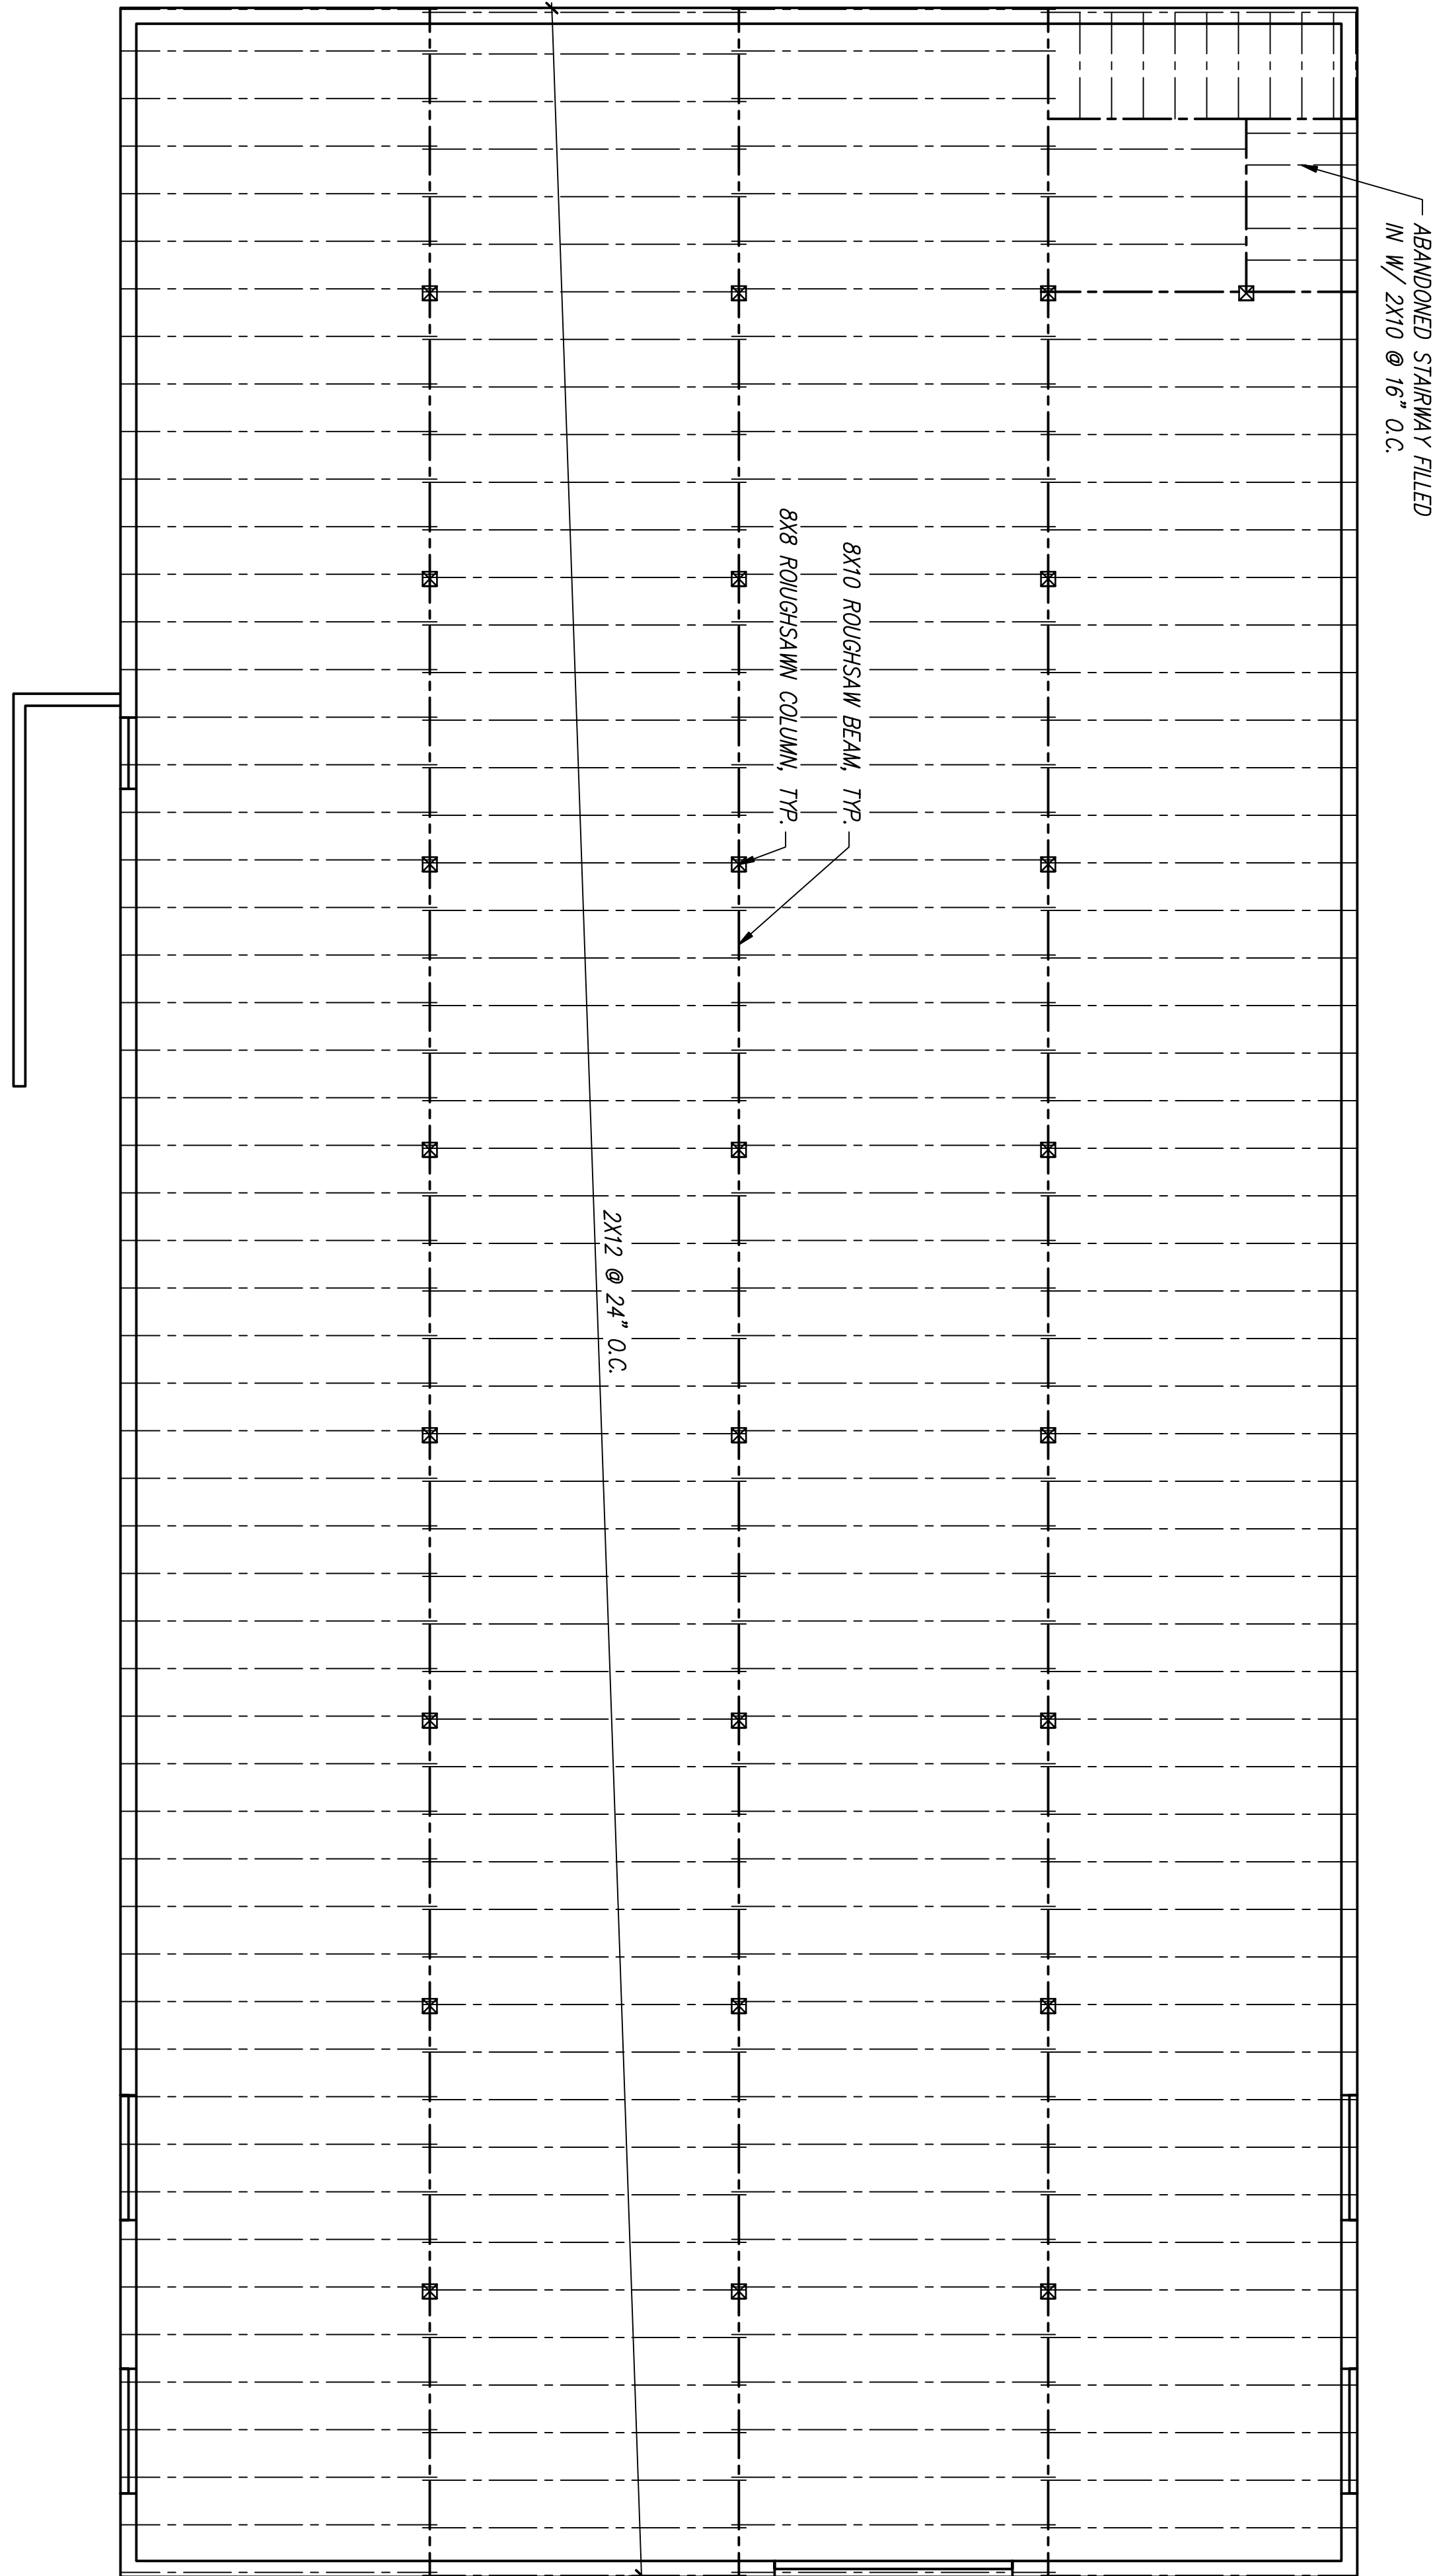

**BARN 1ST FLOOR FRAMING PLAN**


Scales/16" = 1'-0"

DESIGNED BY	CHKD BY	DATE
PROJ. DIRECTOR	DATE	
ISSUE DATE	PROJECT NO.	CLIENT REF.
10/15/2009	D09135.00	
SHEET NO. <b>S4.2</b> OF <b>15</b> SHEETS		

STAR VALLEY RANCH ASSOCIATION  
 AS-BUILT DRAWINGS  
 STAR VALLEY RANCH  
 BARN 1ST FLOOR FRAMING PLAN

**SARGENT**  
 Sargent Engineers, Inc.  
 1290 Arrowhead Plaza Way  
 Driggs, Idaho 83422  
 Tel. 208 354-4400 • Fax 208 354-4420

Rev.	Date	By	Description

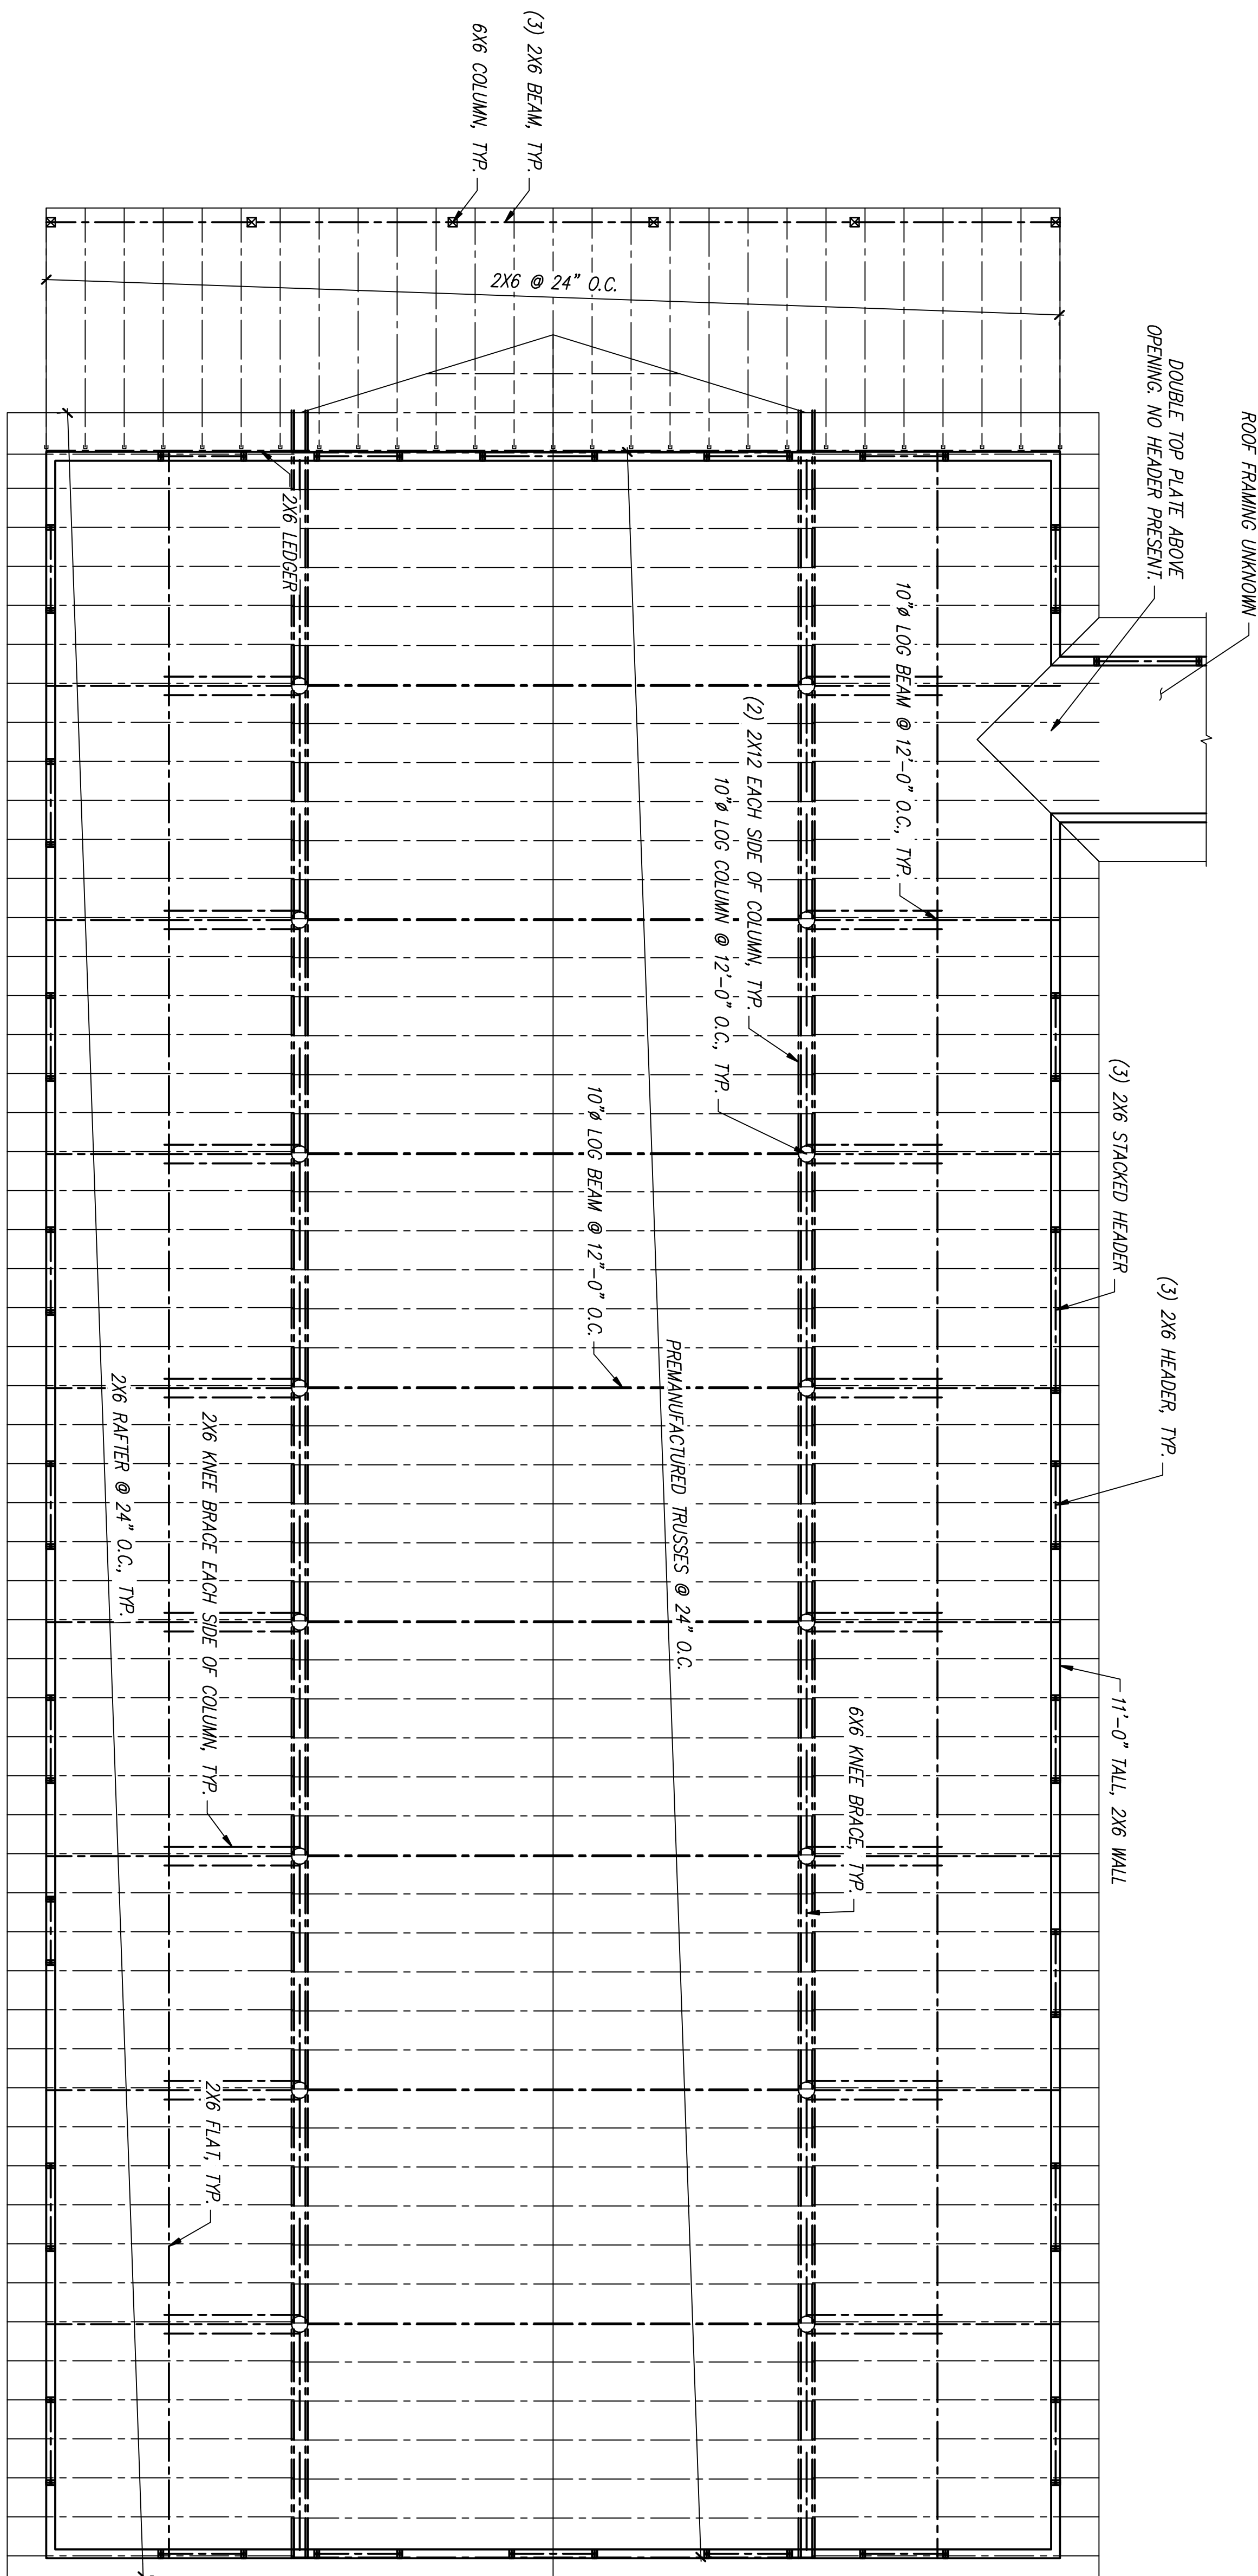

**BARN ROOF FRAMING PLAN**


Scales/16" = 1'-0"

SHEET NO.	S4.3
OF	15
SHEETS	

STAR VALLEY RANCH ASSOCIATION  
AS-BUILT DRAWINGS  
STAR VALLEY RANCH  
BARN ROOF FRAMING PLAN

**SARGENT**  
Sargent Engineers, Inc.  
1290 Arrowhead Plaza Way  
Driggs, Idaho 83422  
Tel. 208 354-4400 • Fax 208 354-4420

Rev.	Date	By	Description

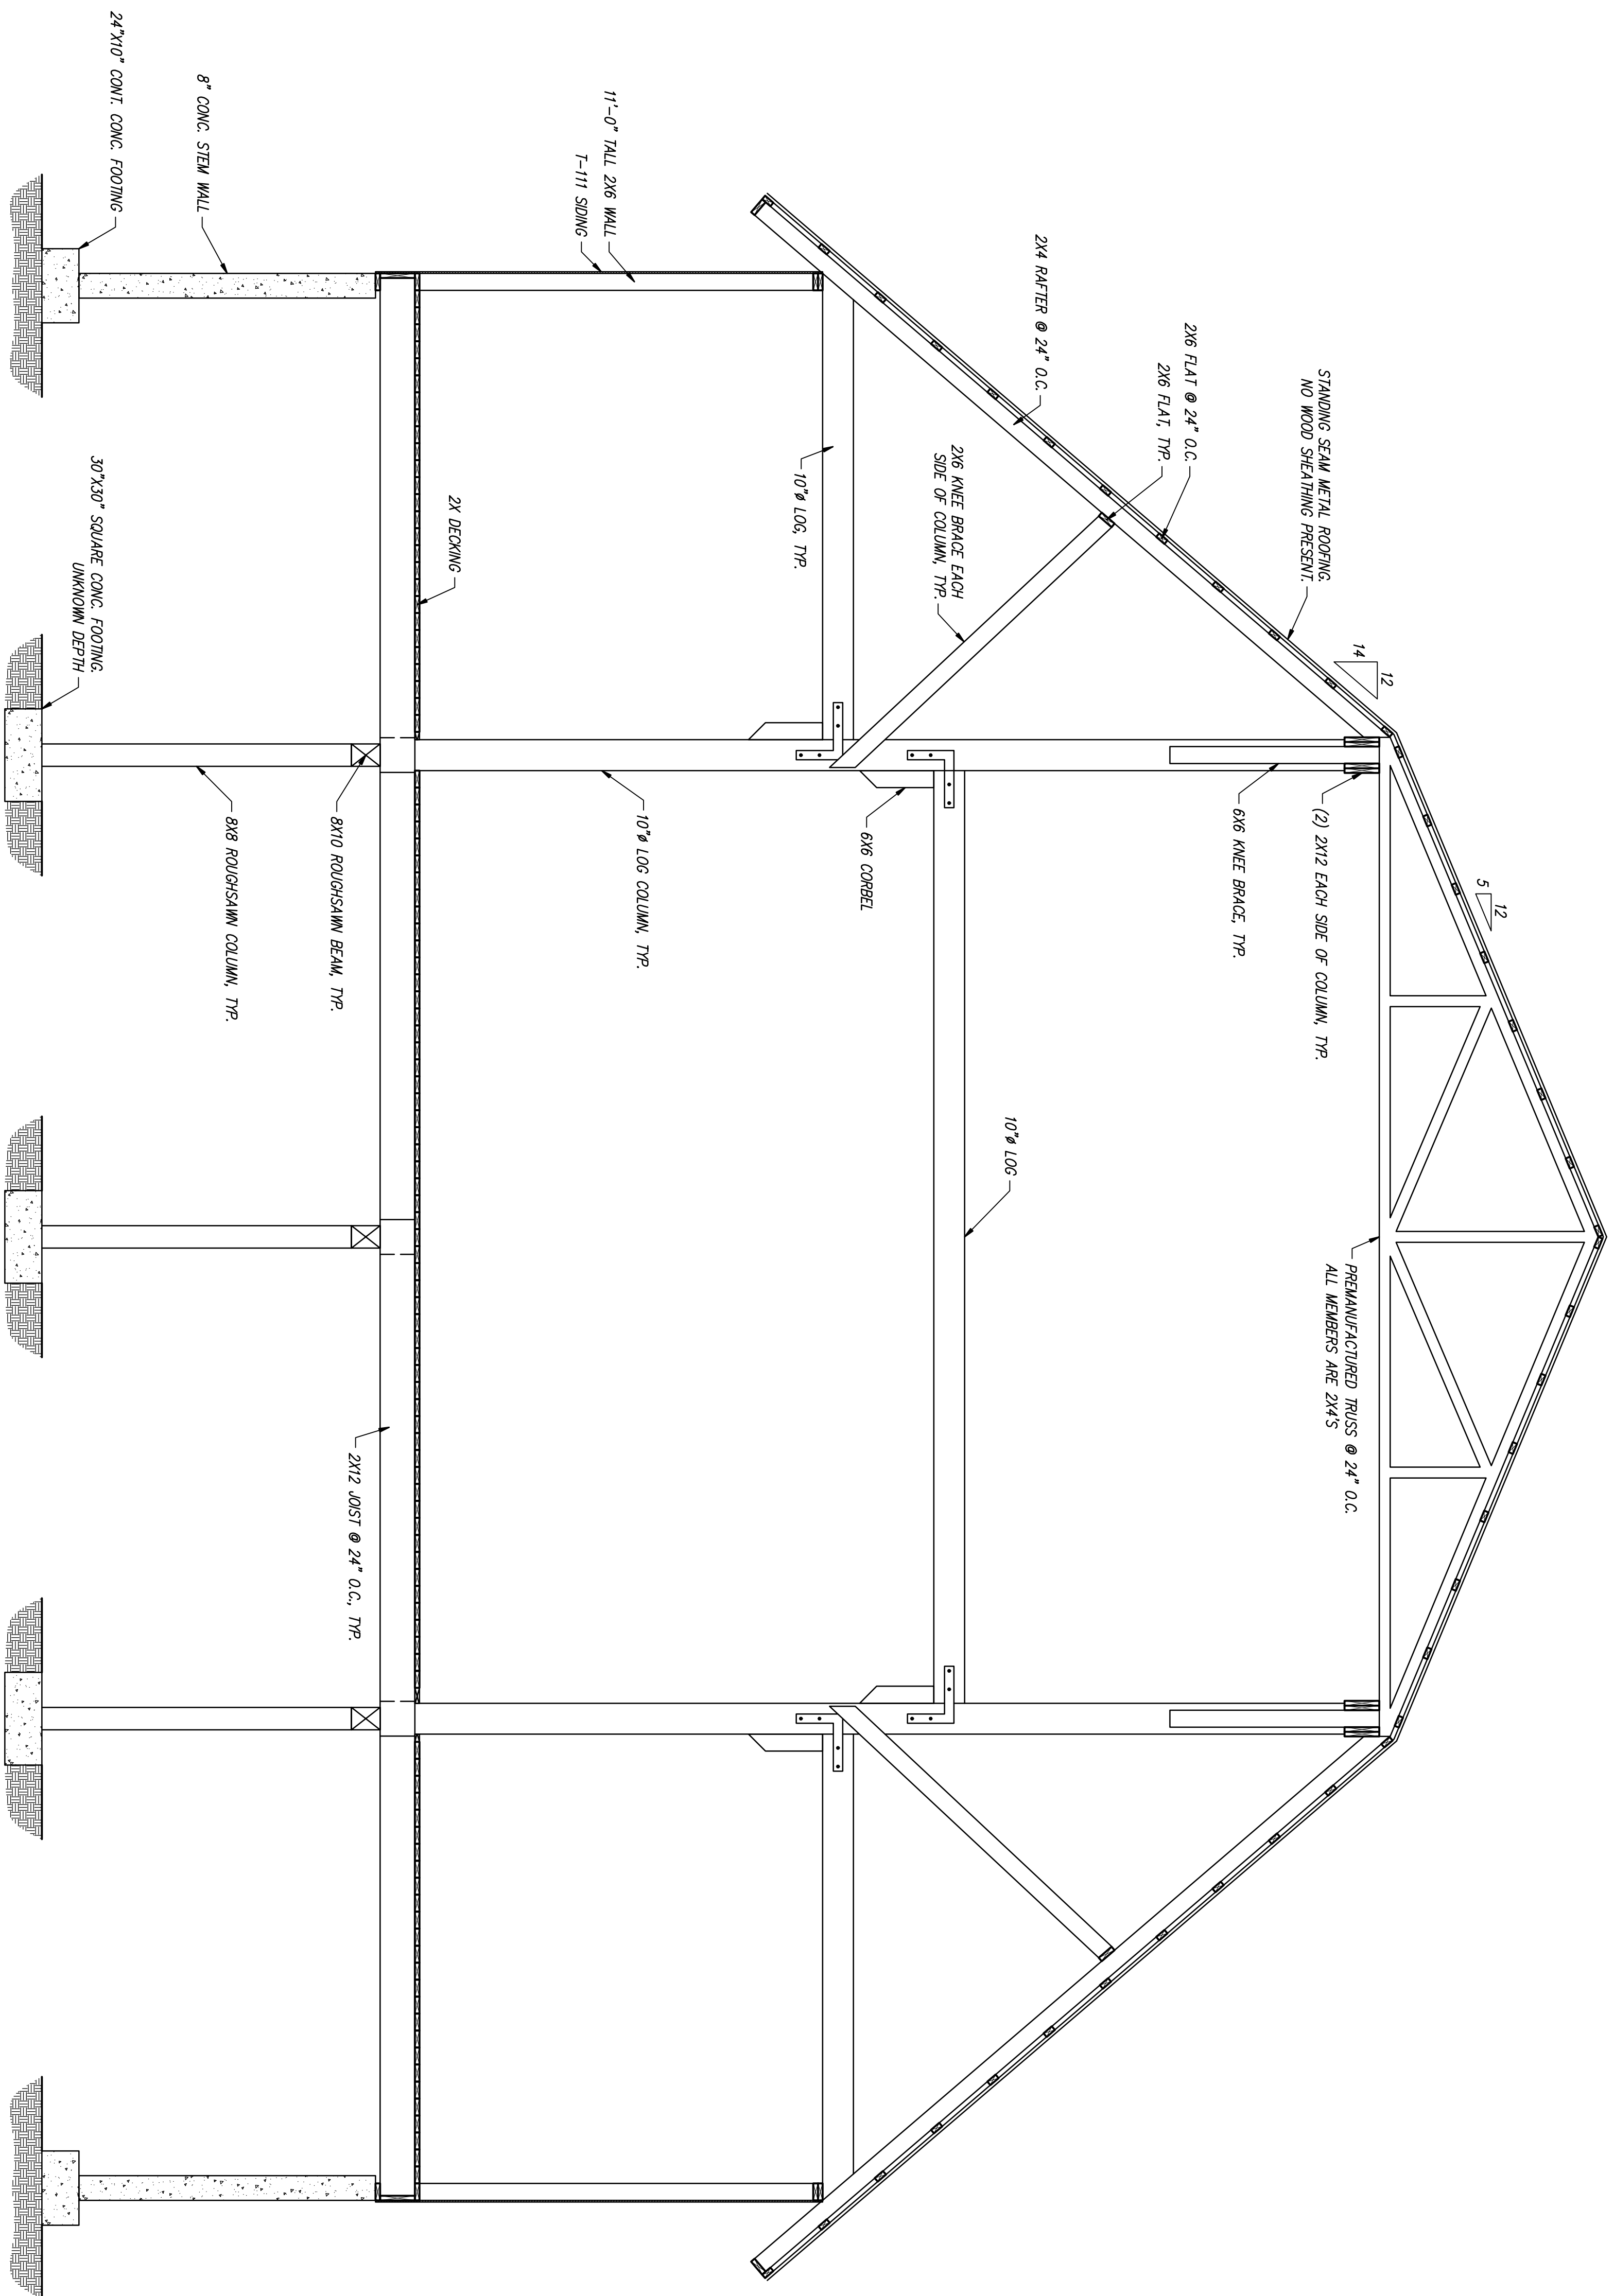

**BARN SECTION**

Scale: 3/8" = 1'-0"

DESIGNED BY	CHKD BY
DRN	MHH
DATE	DATE
10/15/2009	10/15/2009
PROJECT NO.	PROJECT NO.
D09135.00	D09135.00
CLIENT	CLIENT
STAR VALLEY RANCH ASSOCIATION	STAR VALLEY RANCH ASSOCIATION
SHEET NO.	OF
S4.4	15
SHEETS	

STAR VALLEY RANCH ASSOCIATION  
AS-BUILT DRAWINGS  
STAR VALLEY RANCH  
BARN SECTION

**SARGENT**  
Sargent Engineers, Inc.  
1290 Arrowhead Plaza Way  
Driggs, Idaho 83422  
Tel. 208 354-4400 • Fax 208 354-4420

Rev.	Date	By	Description